

**MISSISSIPPI DEPARTMENT OF ENVIRONMENTAL QUALITY**  
Bureau of Land and Water Resources

P. O. Box 10631  
Jackson, MS 39289-0631  
**WATER WELL DRILLERS LOG**

COUNTY WELL LOCATED <i>Walthall</i>	
WELL NUMBER <i>L</i>	CODED
DATE WELL COMPLETED <i>2005</i> <i>4/11/91</i>	

PERMIT NUMBER <i>0-508</i>
NAME OF DRILLING FIRM <i>Jordan Well, Inc.</i>

NAME & MAILING ADDRESS OF LANDOWNER <i>O. D. Kennedy</i> <i>Rt. 1</i> <i>Sandy Hook, Miss</i>		
WELL LOCATION: SEC	TOWNSHIP	RANGE
<i>3</i>	<i>1</i>	<i>N 13 E</i>
DISTANCE	DIRECTION	NEAREST TOWN
<i>10</i> Miles	<i>E</i>	<i>Lytleton</i>
OTHER LANDMARK		
WELL PURPOSE: Home, Irrigation, Municipal, Industrial, Fish Pond, etc. <i>Home</i>		

<b>PUMP DATA</b>		
PUMP TYPE (Circle One): <u>Submersible</u> , Turbine, Jet, Flowing Well, Other (Describe) _____		
POWER TYPE (Circle One): <u>Electric</u> , Tractor, Diesel, Gasoline, Butane, Other (Describe) _____ H/P <i>1/2</i>		
Pump Capacity (GPM) <i>12</i>	No. of Stages <i>8</i>	Setting Depth <i>80</i> FT.
PUMP TEST Well yielded _____ GPM with a drawdown of _____ ft. after _____ hours of pumping		


<b>WELL DATA</b>		
Well Depth <i>85</i>	Casing Diameter (In.) <i>4</i>	Casing Length (Ft.) <i>75</i>
Type of Casing <i>PVC</i>	Hole Depth <i>85</i>	Depth to Static Water Level <i>70</i>
TYPE OF COMPLETION: (Circle One or More): Gravel Packed, Underreamed, Telescoped, Natural Development, Open Hole, Other (Describe) <i>10ft. cement grout</i>		
Top of Lap Pipe or Reduction in Casing  FEET <input type="checkbox"/> IF TELESCOPED OR MORE THAN ONE SCREEN: USE BACK PAGE		

<b>LOG DATA</b>	
TYPE OF LOG RUN (Circle One): <u>Electric</u> , Gamma Ray, Density, Sonic, Neutron, Other (Describe) _____	
Name of Organization Running Log	

<b>SCREEN DATA</b>		
Diameter - Inches <i>4</i>	Length - Feet <i>10</i>	Slot Size - Inches <i>1,012</i>
Screen Type <i>Pvc</i>	Depth to Bottom - Feet <i>75</i>	

<b>GEOLOGIC DATA (Office Use Only)</b>			
Surface Elev.	Geologic Unit	Unit Thickness	Depth to Top
Subs. SWL	Date	Analysis	Aquifer Test
Driller's Remarks			

DESCRIPTION OF FORMATIONS ENCOUNTERED	FROM	TO	FORMATIONS (Continued)	FROM	TO
<i>top soil</i>	<i>0</i>	<i>1</i>			
<i>sandy clay</i>	<i>1</i>	<i>30</i>			
<i>shale</i>	<i>30</i>	<i>60</i>			
<i>gravel</i>	<i>60</i>	<i>70</i>			
<i>sand</i>	<i>70</i>	<i>85</i>			

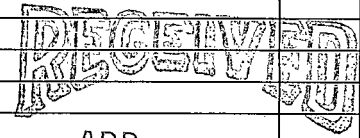


APR 24 1991

Dept. of Environmental Quality  
Bureau of Land & Water Resources

IF MORE SPACE IS NEEDED, USE BACK

If well telescopes please  
sketch and show depths.

GROUND LEVEL

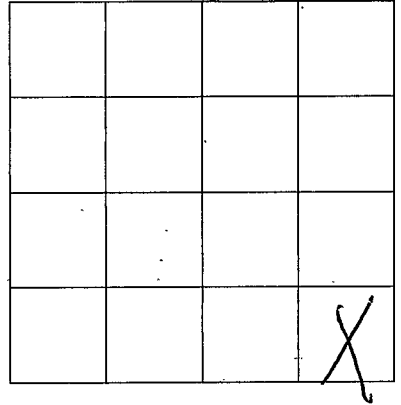

SECTION 3

Please indicate well location X.

ADDITIONAL INFORMATION

If more than one screen,  
show location of each on sketch.