

MISSISSIPPI DEPARTMENT OF ENVIRONMENTAL QUALITY
Bureau of Land and Water Resources

P. O. Box 10631
Jackson, MS 39289-0631
WATER WELL DRILLERS LOG

COUNTY WELL LOCATED <i>Walsh</i>	
WELL NUMBER <i>2</i>	CODED
DATE WELL COMPLETED <i>4/14/92</i>	

PERMIT NUMBER <i>Q-508</i>
NAME OF DRILLING FIRM <i>Jordan Well Dr.</i>

NAME & MAILING ADDRESS OF LANDOWNER <i>Jerry Boyd</i> <i>P.O. Box 221 Angie, LA.</i>			
WELL LOCATION: SEC	TOWNSHIP	RANGE	
<i>3</i>	<i>1</i>	<i>N</i>	<i>13 E</i>
DISTANCE		DIRECTION	NEAREST TOWN
<i>9</i> Miles		<i>E</i>	<i>Julesburg</i>
OTHER LANDMARK			
WELL PURPOSE: <input checked="" type="checkbox"/> Home Irrigation, <input type="checkbox"/> Municipal, <input type="checkbox"/> Industrial, <input type="checkbox"/> Fish Pond, etc.			

PUMP DATA			
PUMP TYPE (Circle One): <input checked="" type="checkbox"/> Submersible, <input type="checkbox"/> Turbine, <input type="checkbox"/> Jet, <input type="checkbox"/> Flowing Well, Other (Describe) _____			
POWER TYPE (Circle One): <input checked="" type="checkbox"/> Electric, <input type="checkbox"/> Tractor, <input type="checkbox"/> Diesel, <input type="checkbox"/> Gasoline, <input type="checkbox"/> Butane, Other (Describe) _____ H/P _____			
Pump Capacity (GPM) <i>18</i>	No. of Stages <i>9</i>	Setting Depth <i>170</i> FT.	
PUMP TEST			
Well yielded _____ GPM with a drawdown of _____ ft. after _____ hours of pumping			

WELL DATA		
Well Depth <i>175</i>	Casing Diameter (In.) <i>4"</i>	Casing Length (Ft.) <i>165</i>
Type of Casing <i>PVC</i>	Hole Depth <i>175</i>	Depth to Static Water Level <i>150</i>
TYPE OF COMPLETION: (Circle One or More): Gravel Packed, Underreamed, Telescoped, Natural Development, Open Hole, Other (Describe) <i>10/4. cement grout</i>		
Top of Lap Pipe or Reduction in Casing		
FEET		
IF TELESCOPED OR MORE THAN ONE SCREEN: USE BACK PAGE		

LOG DATA	
TYPE OF LOG RUN (Circle One): <input type="checkbox"/> No Log Run, <input type="checkbox"/> Electric, <input type="checkbox"/> Gamma Ray, <input type="checkbox"/> Density, <input type="checkbox"/> Sonic, <input type="checkbox"/> Neutron, Other (Describe) _____	
Name of Organization Running Log	

SCREEN DATA		
Diameter - Inches <i>4"</i>	Length - Feet <i>10'</i>	Slot Size - Inches <i>.012</i>
Screen Type <i>PVC</i>	Depth to Bottom - Feet <i>165</i>	


GEOLOGIC DATA (Office Use Only)			
Surface Elev.	Geologic Unit	Unit Thickness	Depth to Top
Subs. SWL	Date	Analysis	Aquifer Test

Driller's Remarks

DESCRIPTION OF FORMATIONS ENCOUNTERED	FROM	TO	FORMATIONS (Continued)	FROM	TO
<i>top soil</i>	<i>0</i>	<i>1</i>	<i>course sand</i>	<i>145</i>	<i>175</i>
<i>sandy clay</i>	<i>1</i>	<i>50</i>	RECEIVED MAY 01 1992		
<i>shale</i>	<i>50</i>	<i>95</i>			
<i>fine sand</i>	<i>95</i>	<i>130</i>			
<i>shale</i>	<i>130</i>	<i>145</i>			

If well telescopes please sketch and show depths.

GROUND LEVEL

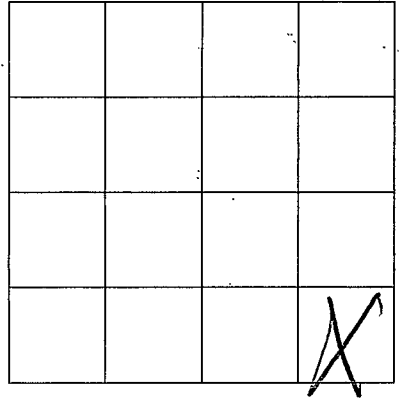

SECTION 3

Please indicate well location X.

ADDITIONAL INFORMATION

If more than one screen,
show location of each on sketch.