

MISSISSIPPI DEPARTMENT OF ENVIRONMENTAL QUALITY
Bureau of Land and Water Resources

P. O. Box 10631
Jackson, MS 39289-0631
WATER WELL DRILLERS LOG

COUNTY WELL LOCATED Waltham	WELL NUMBER L	CODED
DATE WELL COMPLETED 2008 1/25/93		

PERMIT NUMBER 0-508
NAME OF DRILLING FIRM Jordan Well Ser.

NAME & MAILING ADDRESS OF LANDOWNER Brett Jones tyler town, Miss.			
WELL LOCATION: SEC	TOWNSHIP	RANGE	
3	1	N	13
		S	E
			W
DISTANCE	DIRECTION	NEAREST TOWN	
8 Miles	SE	tyler town	
OTHER LANDMARK			
WELL PURPOSE: <input checked="" type="radio"/> Home Irrigation, Municipal, Industrial, Fish Pond, etc.			

PUMP DATA		
PUMP TYPE (Circle One): <input checked="" type="radio"/> Submersible, Turbine, Jet, Flowing Well, Other (Describe) _____		
POWER TYPE (Circle One): <input checked="" type="radio"/> Electric, Tractor, Diesel, Gasoline, Butane, Other (Describe) _____ H/P _____		
Pump Capacity (GPM) 18	No. of Stages 9	Setting Depth 135 FT.
PUMP TEST		
Well yielded _____ GPM with a drawdown of _____ ft. after _____ hours of pumping		

WELL DATA		
Well Depth 140	Casing Diameter (In.) 4	Casing Length (Ft.) 130
Type of Casing PVC	Hole Depth 140	Depth to Static Water Level 115
TYPE OF COMPLETION: (Circle One or More): Gravel Packed, Underreamed, Telescoped, Natural Development, Open Hole, Other (Describe) 10ft. cement Grout		
Top of Lap Pipe or Reduction in Casing		
FEET	IF TELESCOPED OR MORE THAN ONE SCREEN: USE BACK PAGE	

LOG DATA	
TYPE OF LOG RUN (Circle One): No Log Run, Electric, Gamma Ray, Density, Sonic, Neutron, Other (Describe) _____	
Name of Organization Running Log	

SCREEN DATA		
Diameter - Inches 4	Length - Feet 10	Slot Size - Inches .012
Screen Type PVC	Depth to Bottom - Feet 130	

GEOLOGIC DATA (Office Use Only)			
Surface Elev.	Geologic Unit	Unit Thickness	Depth to Top
Subs. SWL	Date	Analysis	Aquifer Test

Driller's Remarks

DESCRIPTION OF FORMATIONS ENCOUNTERED	FROM	TO	FORMATIONS (Continued)	FROM	TO
top soil	0	1			
Sandy Clay	1	45			
SHale	45	70			
Gravel	70	95			
course sand	95	140			

RECEIVED


FEB 08 1993

Dept. of Environmental Quality
Office of Land & Water Resources

IF MORE SPACE IS NEEDED, USE BACK.

If well telescopes please
sketch and show depths.

GROUND LEVEL

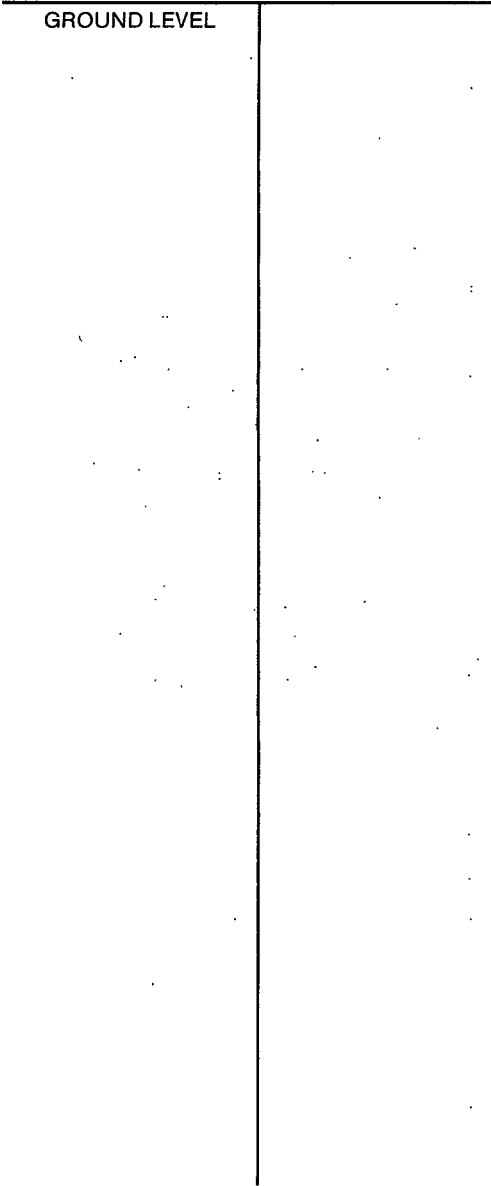

If more than one screen,
show location of each on sketch.

			X

SECTION 3

Please indicate well location X.

ADDITIONAL INFORMATION

