

MISSISSIPPI DEPARTMENT OF ENVIRONMENTAL QUALITY
Bureau of Land and Water Resources

P. O. Box 10631
Jackson, MS 39289-0631
WATER WELL DRILLERS LOG

COUNTY WELL LOCATED <i>Walthall</i>	
WELL NUMBER <i>2</i>	CODED
DATE WELL COMPLETED <i>Oct. 22, 93</i>	

PERMIT NUMBER <i>0-508</i>
NAME OF DRILLING FIRM <i>Jordan Well Ser.</i>

NAME & MAILING ADDRESS OF LANDOWNER <i>Kelvin Creel</i> <i>Tyler town, Miss.</i>			
WELL LOCATION: SEC	TOWNSHIP	RANGE	
<i>3</i>	<i>1 N</i>	<i>13 E</i>	
	<i>S</i>	<i>W</i>	
DISTANCE	DIRECTION	NEAREST TOWN	
<i>9</i> Miles	<i>SE</i>	<i>tylertown</i>	
OTHER LANDMARK			
WELL PURPOSE <input checked="" type="checkbox"/> Home Irrigation, Municipal, Industrial, Fish Pond, etc.			

PUMP DATA			
PUMP TYPE (Circle One): <input checked="" type="radio"/> Submersible, Turbine, Jet, Flowing Well, Other (Describe) _____			
POWER TYPE (Circle One): <input checked="" type="radio"/> Electric, Tractor, Diesel, Gasoline, Butane, Other (Describe) _____ H/P <i>1</i>			
Pump Capacity (GPM)	No. of Stages	Setting Depth	
<i>10</i>	<i>15</i>	<i>190</i>	FT.
PUMP TEST			
Well yielded _____ GPM with a drawdown of _____ ft. after _____ hours of pumping			

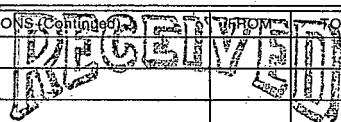
WELL DATA		
Well Depth <i>200</i>	Casing Diameter (In.) <i>4"</i>	Casing Length (Ft.) <i>190</i>
Type of Casing <i>PVC</i>	Hole Depth <i>200</i>	Depth to Static Water Level <i>140</i>
TYPE OF COMPLETION: (Circle One or More): Gravel Packed, Underreamed, Telescoped, Natural Development, Open Hole, Other (Describe) <i>10ft. Cement Grout</i>		
Top of Lap Pipe or Reduction in Casing		
FEET	IF TELESCOPED OR MORE THAN ONE SCREEN: USE BACK PAGE	

LOG DATA	
TYPE OF LOG RUN (Circle One): No Log Run, Electric, Gamma Ray, Density, Sonic, Neutron, Other (Describe) _____	
Name of Organization Running Log	

SCREEN DATA		
Diameter - Inches <i>4</i>	Length - Feet <i>10</i>	Slot Size - Inches <i>1012</i>
Screen Type <i>PVC</i>	Depth to Bottom - Feet <i>190</i>	

GEOLOGIC DATA (Office Use Only)			
Surface Elev.	Geologic Unit	Unit Thickness	Depth to Top
Subs. SWL	Date	Analysis	Aquifer Test

Driller's Remarks

DESCRIPTION OF FORMATIONS ENCOUNTERED	FROM	TO	FORMATIONS (Continued)	FROM	TO
<i>Top Soil</i>	<i>0</i>	<i>1</i>	 NOV 05 1993 Dept. of Environmental Quality Office of Land & Water Resources		
<i>Sandy Clay</i>	<i>1</i>	<i>50</i>			
<i>Shale</i>	<i>50</i>	<i>140</i>			
<i>Fine Sand</i>	<i>140</i>	<i>170</i>			
<i>Course Sand</i>	<i>170</i>	<i>200</i>			

IF MORE SPACE IS NEEDED, USE BACK

If well telescopes please sketch and show depths.

GROUND LEVEL

			X

SECTION 3

Please indicate well location X.

ADDITIONAL INFORMATION

If more than one screen,
show location of each on sketch.