

**MISSISSIPPI DEPARTMENT OF ENVIRONMENTAL QUALITY**  
Bureau of Land and Water Resources

P. O. Box 10631  
Jackson, MS 39289-0631  
**WATER WELL DRILLERS LOG**

COUNTY WELL LOCATED: <b>WATHAIN</b>	
WELL NUMBER <b>2</b>	CODED
DATE WELL COMPLETED <b>3/24/95</b>	

PERMIT NUMBER <b>0-508</b>
NAME OF DRILLING FIRM <b>Jordan Well Ser.</b>

NAME & MAILING ADDRESS OF LANDOWNER <b>Andrey Lee Russ</b>			
<b>P.O. Box 194</b>			
<b>Angie, LA. 70426</b>			
WELL LOCATION:	SEC	TOWNSHIP	RANGE
	<b>3</b>	<b>1</b> N S	<b>13</b> E W
DISTANCE	DIRECTION	NEAREST TOWN	
<b>3</b> Miles	<b>ENE</b>	of <b>Angie, LA.</b>	
OTHER LANDMARK			
WELL PURPOSE: <input checked="" type="checkbox"/> Home Irrigation, Municipal, Industrial, Fish Pond, etc.			

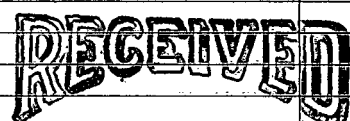
<b>PUMP DATA</b>			
PUMP TYPE (Circle One): <input checked="" type="checkbox"/> Submersible Turbine, Jet Flowing Well, Other (Describe) _____			
POWER TYPE (Circle One): <input checked="" type="checkbox"/> Electric Tractor, Diesel, Gasoline, Butane, Other (Describe) <b>1</b> H/P _____			
Pump Capacity (GPM)	No. of Stages	Setting Depth	
<b>10</b>	<b>15</b>	<b>135</b> FT.	
PUMP TEST			
Well yielded _____ GPM with a drawdown of _____ ft. after _____ hours of pumping			

<b>WELL DATA</b>		
Well Depth <b>140</b>	Casing Diameter (In.) <b>4</b>	Casing Length (Ft.) <b>130</b>
Type of Casing <b>PVC</b>	Hole Depth <b>140</b>	Depth to Static Water Level <b>120</b>
TYPE OF COMPLETION: (Circle One or More): Gravel Packed, Underreamed, Telescoped, Natural Development, Open Hole, Other (Describe) <b>100% cement Grout</b>		
Top of Lap Pipe or Reduction in Casing		
FEET IF TELESCOPED OR MORE THAN ONE SCREEN: USE BACK PAGE		

<b>LOG DATA</b>	
TYPE OF LOG RUN (Circle One): No Log Run, Electric, Gamma Ray, Density, Sonic, Neutron, Other (Describe) _____	
Name of Organization Running Log	

<b>SCREEN DATA</b>		
Diameter - Inches <b>4</b>	Length - Feet <b>10</b>	Slot Size - Inches <b>10/32</b>
Screen Type <b>PVC</b>	Depth to Bottom - Feet <b>130</b>	

<b>GEOLOGIC DATA (Office Use Only)</b>			
Surface Elev.	Geologic Unit	Unit Thickness	Depth to Top
Subs. SWL	Date	Analysis	Aquifer Test

DESCRIPTION OF FORMATIONS ENCOUNTERED	FROM	TO	FORMATIONS (Continued)	FROM	TO
<b>top soil</b>	<b>0</b>	<b>1</b>	 <b>APR 14 1995</b> Dept. of Environmental Quality Office of Land & Water Resources		
<b>SANDY CLAY</b>	<b>1</b>	<b>55</b>			
<b>Dry SAND</b>	<b>55</b>	<b>130</b>			
<b>SAND</b>	<b>120</b>	<b>140</b>			
			IF MORE SPACE IS NEEDED, USE BACK		

If well telescopes please sketch and show depths.

GROUND LEVEL

			X

SECTION 3

Please indicate well location X.

ADDITIONAL INFORMATION

If more than one screen,  
show location of each on sketch.