

MISSISSIPPI DEPARTMENT OF ENVIRONMENTAL QUALITY

Office of Land and Water Resources

P. O. Box 10631
Jackson, MS 39289-0631

WATER WELL DRILLERS LOG

COUNTY WELL LOCATED WAITNAH	
WELL NUMBER L 2017	CODED
DATE WELL COMPLETED 3/11/96	

PERMIT NUMBER 0-508
NAME OF DRILLING FIRM Jordan Well Ser.

NAME & MAILING ADDRESS OF LANDOWNER Don Miley Tylertown, Miss			
WELL LOCATION	SEC	TOWNSHIP	RANGE
	3	1	N 13 E S 13 W
DISTANCE	DIRECTION	NEAREST TOWN	
10 Miles	S/E	tylertown	
OTHER LANDMARK			
WELL PURPOSE: <input checked="" type="checkbox"/> Home Irrigation, Municipal, Industrial, Fish Pond, etc.			

PUMP DATA			
PUMP TYPE (Circle One): <input checked="" type="checkbox"/> Submersible Turbine Jet Flowing Well, Other (Describe) _____			
POWER TYPE (Circle One): <input checked="" type="checkbox"/> Electric Tractor, Diesel, Gasoline, Butane, Other (Describe) _____ H/P _____			
Pump Capacity (GPM) 10	No. of Stages 8	Setting Depth 130 FT.	
PUMP TEST			
Well yielded _____ GPM with a drawdown of _____ ft. after _____ hours of pumping			

WELL DATA		
Well Depth 140	Casing Diameter (In.) 4	Casing Length (Ft.) 130
Type of Casing Pvc	Hole Depth 140	Depth to Static Water Level 80
TYPE OF COMPLETION: (Circle One or More): Gravel Packed, Underreamed, Telescoped, Natural Development, Open Hole, Other (Describe) _____		
WELL GROUTED TO A DEPTH OF 10 FEET Type Grout (circle one): <input checked="" type="checkbox"/> Cement, Bentonite, or Mix		

LOG DATA	
TYPE OF LOG RUN (Circle One): <input type="checkbox"/> No Log Run, <input type="checkbox"/> Electric, Gamma Ray, Density, Sonic, Neutron, Other (Describe) _____	
Name of Organization Running Log	

SCREEN DATA		
Diameter - Inches 4	Length - Feet 10	Slot Size - Inches .010
Screen Type PVC	Depth to Bottom - Feet 130	

GEOLOGIC DATA (Office Use Only)			
Surface Elev.	Geologic Unit	Unit Thickness	Depth to Top
Subs. SWL	Date	Analysis	Aquifer Test


Driller's Remarks	
Top of Lap Pipe or Reduction in Casing	
IF TELESCOPED OR MORE THAN ONE SCREEN USE BACK PAGE	

DESCRIPTION OF FORMATIONS ENCOUNTERED	FROM	TO
top soil	0	1
sandy clay	1	40
SHALE	40	80
SAND	80	140

FORMATIONS (continued)	FROM	TO
MAR 20 1996		
Dept. of Environmental Quality Office of Land & Water Resources		
IF MORE SPACE IS NEEDED, USE BACK		

If well telescopes please
sketch and show depths.

GROUND LEVEL

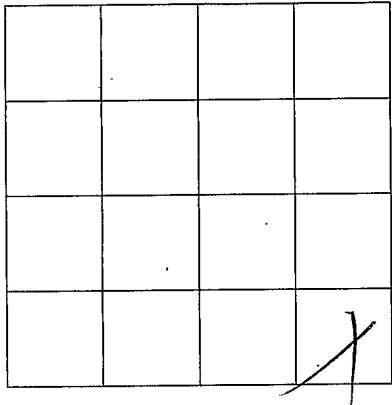

SECTION 3

Please indicate well location X.

ADDITIONAL INFORMATION

If more than one screen,
show location of each on sketch.