

MISSISSIPPI DEPARTMENT OF ENVIRONMENTAL QUALITY
Bureau of Land and Water Resources

P. O. Box 10631
Jackson, MS 39289-0631
WATER WELL DRILLERS LOG

COUNTY WELL LOCATED <i>Walton</i>
WELL NUMBER CODED <i>L 2018</i>
DATE WELL COMPLETED <i>6/4/96</i>

PERMIT NUMBER <i>0-508</i>
NAME OF DRILLING FIRM <i>Jordan Well Ser.</i>

NAME & MAILING ADDRESS OF LANDOWNER <i>Denver Woodward Tylertown, Miss.</i>			
WELL LOCATION:	SEC <i>3</i>	TOWNSHIP <i>1 N</i>	RANGE <i>13 E</i>
DISTANCE <i>9</i> Miles	DIRECTION <i>SE</i>	NEAREST TOWN <i>Tylertown</i>	
OTHER LANDMARK			
WELL PURPOSE: <input checked="" type="checkbox"/> Home Irrigation, Municipal, Industrial, Fish Pond, etc.			

PUMP DATA		
PUMP TYPE (Circle One): <input checked="" type="checkbox"/> Submersible, Turbine, Jet, Flowing Well, Other (Describe) _____		
POWER TYPE (Circle One): <input checked="" type="checkbox"/> Electric, Tractor, Diesel, Gasoline, Butane, Other (Describe) _____ H/P _____		
Pump Capacity (GPM) <i>10</i>	No. of Stages <i>15</i>	Setting Depth <i>165</i> FT.
PUMP TEST		
Well yielded _____ GPM with a drawdown of _____ ft. after _____ hours of pumping		

WELL DATA		
Well Depth <i>170</i>	Casing Diameter (In.) <i>4</i>	Casing Length (Ft.) <i>160</i>
Type of Casing <i>PDC</i>	Hole Depth <i>170</i>	Depth to Static Water Level <i>135</i>
TYPE OF COMPLETION: (Circle One or More): Gravel Packed, Underreamed, Telescoped, Natural Development, Open Hole, Other (Describe) <i>10% cement Grout</i>		
Top of Lap Pipe or Reduction in Casing		
FEET IF TELESCOPED OR MORE THAN ONE SCREEN: USE BACK PAGE		

LOG DATA	
TYPE OF LOG RUN (Circle One): No Log Run, Electric, Gamma Ray, Density, Sonic, Neutron, Other (Describe) _____	
Name of Organization Running Log	


SCREEN DATA		
Diameter - Inches <i>4</i>	Length - Feet <i>10</i>	Slot-Size - Inches <i>.010</i>
Screen Type <i>PDC</i>	Depth to Bottom - Feet <i>160</i>	

GEOLOGIC DATA (Office Use Only)			
Surface Elev.	Geologic Unit	Unit Thickness	Depth to Top
Subs. SWL	Date	Analysis	Aquifer Test
Driller's Remarks RECEIVED <i>JUN 07 1996</i>			

DESCRIPTION OF FORMATIONS ENCOUNTERED	FROM	TO	Dart. of Environmental Quality Bureau of Land & Water Resources	
			FROM	TO
<i>top soil</i>	<i>0</i>	<i>1</i>		
<i>sandy clay</i>	<i>1</i>	<i>55</i>		
<i>shale</i>	<i>55</i>	<i>140</i>		
<i>sand</i>	<i>140</i>	<i>170</i>		
IF MORE SPACE IS NEEDED, USE BACK				

If well telescopes please sketch and show depths.

GROUND LEVEL

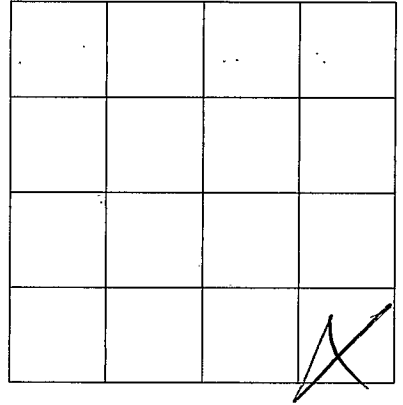

SECTION 3

Please indicate well location X.

ADDITIONAL INFORMATION

If more than one screen,
show location of each on sketch.