

MISSISSIPPI DEPARTMENT OF ENVIRONMENTAL QUALITY

Office of Land and Water Resources

P. O. Box 10631
Jackson, MS 39289-0631
WATER WELL DRILLERS LOG

COUNTY WELL LOCATED <u>Walthall</u>	
WELL NUMBER <u>9 L 2024</u>	CODED
DATE WELL COMPLETED <u>5-1-98</u>	

PERMIT NUMBER <u>0-621</u>
NAME OF DRILLING FIRM <u>Daniel Boone's Water Well</u>
<u>Sandy Hook MS</u>

NAME & MAILING ADDRESS OF LANDOWNER <u>Daniel Boone</u>		
<u>21 Stagner Rd.</u>		
<u>Sandy Hook, MS</u>		
WELL LOCATION: SEC	TOWNSHIP	RANGE
<u>16</u>	<u>1</u>	<u>N 16 E</u>
DISTANCE	DIRECTION	NEAREST TOWN
<u>5 1/2</u> Miles	<u>East</u> of	<u>Dexter</u>
OTHER LANDMARK <u>Community of Improve</u>		
WELL PURPOSE: Home Irrigation, Municipal, Industrial, Fish Pond, etc.		

PUMP DATA		
PUMP TYPE (Circle One): <u>Submersible</u> , Turbine, Jet, Flowing Well, Other (Describe) _____		
POWER TYPE (Circle One): <u>Electric</u> , Tractor, Diesel, Gasoline, Butane, Other (Describe) _____ H/P <u>1</u>		
Pump Capacity (GPM) <u>12</u>	No. of Stages	Setting Depth <u>130</u> FT.
PUMP TEST		
Well yielded <u>12</u> GPM with a drawdown of <u>20</u> ft. after <u>36</u> hours of pumping		

WELL DATA		
Well Depth <u>180</u>	Casing Diameter (In.) <u>4"</u>	Casing Length (Ft.) <u>160</u>
Type of Casing <u>PVC</u>	Hole Depth <u>180</u>	Depth to Static Water Level <u>90'</u>
TYPE OF COMPLETION: (Circle One or More): <u>Gravel Packed</u> , Underreamed, Telescoped, Natural Development, Open Hole, Other (Describe) _____		
WELL GROUTED TO A DEPTH OF <u>9</u> FEET Type Grout (circle one): Cement, Bentonite, or Mix		

LOG DATA	
TYPE OF LOG RUN (Circle One): Electric, Gamma Ray, Density, Sonic, Neutron, Other (Describe) _____ <u>No Log Run</u>	
Name of Organization Running Log	

SCREEN DATA		
Diameter - Inches <u>4"</u>	Length - Feet <u>20'</u>	Slot Size - Inches <u>.008</u>
Screen Type <u>PVC</u>	Depth to Bottom - Feet <u>1' off Bottom</u>	


GEOLOGIC DATA (Office Use Only)			
Surface Elev.	Geologic Unit	Unit Thickness	Depth to Top
Subs. SWL	Date	Analysis	Aquifer Test
Driller's Remarks			
Top of Lap Pipe or Reduction in Casing			
FEET IF TELESKOPED OR MORE THAN ONE SCREEN: USE BACK PAGE			

DESCRIPTION OF FORMATIONS ENCOUNTERED	FROM	TO
<u>Clay</u>	<u>0</u>	<u>10</u>
<u>Sand</u>	<u>10</u>	<u>18</u>
<u>Clay</u>	<u>18</u>	<u>65</u>
<u>Sand</u>	<u>65</u>	<u>80</u>
<u>Clay</u>	<u>80</u>	<u>115</u>
<u>Sand</u>	<u>115</u>	<u>180</u>

FORMATIONS (Continued)	FROM	TO
RECEIVED		
JUN 11 1998		
Dept. of Environmental Quality Office of Land & Water Resources		
IF MORE SPACE IS NEEDED, USE BACK		

If well telescopes please sketch and show depths.

GROUND LEVEL

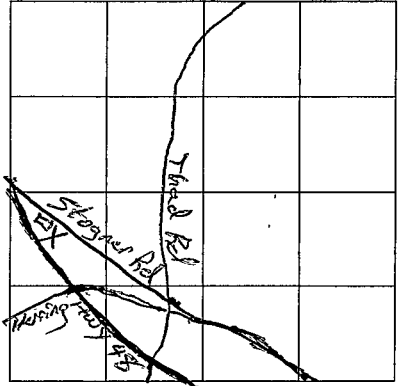

SECTION 162

Please indicate well location X.

ADDITIONAL INFORMATION

The Well is on 5 ACRES directly behind Carson Springs ~~the~~ Baptist Church. The land is 16th Section & the lease belongs to my wife Monticth Boone.

If more than one screen, show location of each on sketch.