

WARREN WATER WELL DRILLERS LOG

Date: Oct 26, 1962, Driller: D H Williams County Warren
 (Name)

(1) Owner of Land: Cecil Travis
 (Name)
Playa Bldg Jackson Miss
 (Address)

(2) Location: 1/4, 1/4, Sec. T R
1 miles South, of Shipoids
 (distance) (direction) (Nearest Town)
Eagle Lake
 (3) Topography: (Delta)
 (Hilly) (Flat) (Level)

(4) Purpose of Well: Club House on Lake
 (Domestic Irrigation
 Municipal, Industrial, Other)

Description & Color of Materials Sand, Clay, Red Clay, Shell, etc.	Thick- ness Feet	Depth Feet
<u>1 to 34 surface</u>		
<u>delta Black Gumbo</u>	<u>34</u>	<u>34</u>
<u>34 to 64 Soft Block</u>		
<u>Mud =</u>	<u>30</u>	<u>64</u>
<u>64 to 74 coarse</u>		
<u>Sand some mud</u>	<u>10</u>	<u>74</u>
<u>74 to 84 Fine Sand</u>	<u>10</u>	<u>84</u>
<u>84 to 130 coarse</u>		
<u>Sand some small</u>		
<u>Gravel</u>	<u>46</u>	<u>130</u>

Information upon completion of well:

(1) Diameter 4" inches.

(2) Total Depth 130 feet.

(3) Water Level 30 feet below top of ground.

(4) Cased to 110, Size 2"


(5) Screen: Size 2", Length 10ft

(6) Were any formations sealed against pollution?
 yes, no.

If YES depth of formation 74

Why Keep back Pollution from
Surface + mud at

Drillers Remarks: 34 to 64
Well Cemented bet to 74
& Top down to 20'

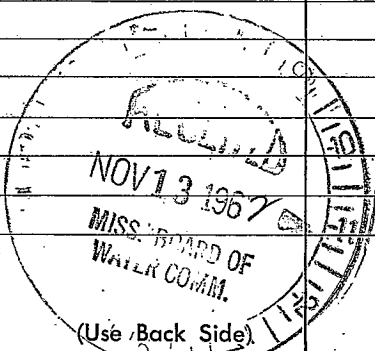

Well No.

