

WARREN  
A1  
11-5-73

MISSISSIPPI  
BOARD OF WATER COMMISSIONERS  
416 North State Street  
Jackson, Mississippi 39201

CODED

WATER WELL DRILLERS LOG

Nov. 5 1973 E.M. "Bud" Cresswell WARREN  
date well completed firm name county well located

LANDOWNER: HARVEY McGehee II  
JACKSON, Miss.  
(mailing address)

description of formations encountered

	from	to
CLAY	0	40
SAND - GRAVEL	40	110

WELL LOCATION:  
sec. 6 T. 18 N R. 2 E W  
3 miles N-W of Eagle LA.  
(distance) (direction) (nearest town)

WELL PURPOSE: Home  
(home, irrigation, municipal, industrial)

WELL COMPLETION DATA:

(1) diameter (inches) 2

(2) total depth (feet) 110

(3) static water level (feet) 18 below top of ground.

(4) casing Steel, 105 (material) (depth)

(size) if telescope see back.

(5) screen 5, 105 (length) (depth to top)

(size) 2, STAINLESS (material)

(6) pump 3/4 (HP) 5 (yield gpm)

(type power)

(7) electric log no (yes or no)

(organization running log)

(8) how well bottom plugged Steel plug


CODED

DRILLERS REMARKS:

11-5-73

If well telescopes please sketch and show depths.

GROUND LEVEL

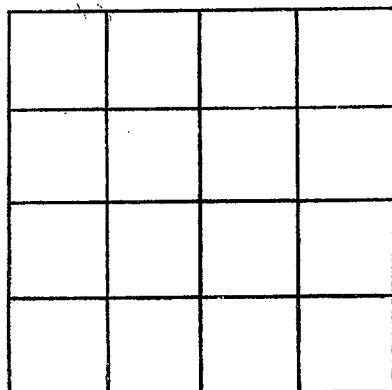

SECTION \_\_\_\_\_

Please indicate well location X.

ADDITIONAL INFORMATION

If more than one screen,  
show locations of each on sketch.