

WARREN
A 12
3-29-80

MISSISSIPPI
BOARD OF WATER COMMISSIONERS
416 North State Street
Jackson, Mississippi 39201

CODED

WATER WELL DRILLERS LOG

MARCH 29 1980 E.M. "Bud" CRESSWELL WARREN
date well completed firm name county well located

LANDOWNER:
LARRY Crowe
Vicksburg, Mo.
(mailing address)

description of formations encountered	from	to
Clay	0	50
Sand & gravel	50	150

WELL LOCATION:
sec. 5 T 17 N R 2 E
AT Eagle LAKE
(distance) 1 1/2 (direction) of (nearest town)

WELL PURPOSE: FARM
(home, irrigation, municipal, industrial)

- WELL COMPLETION DATA:
- (1) diameter (inches) 4
 - (2) total depth (feet) 150
 - (3) static water level (feet) 15 below top of ground.
 - (4) casing PVC 110
(material) (depth)
4 if telescope see back.
(size)
 - (5) screen 40 110
(length) (depth to top)
4 PVC
(size) (material)
 - (6) pump 2 50
(HP) (yield gpm)
0
(type power)
 - (7) electric log no
(yes or no)
0
(organization running log)

(8) how well bottom plugged
back wash valve


DRILLERS REMARKS:

CODED

DEPT. OF NATURAL RESOURCES
BUREAU OF LAND & WATER RESOURCES
APR - 4 1980
RECEIVED

If well telescopes please sketch and show depths.

GROUND LEVEL

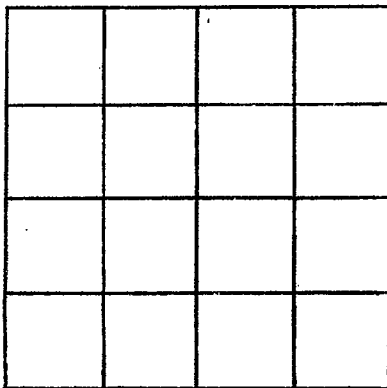

SECTION _____

Please indicate well location X.

ADDITIONAL INFORMATION

If more than one screen,
show locations of each on sketch.