

MISSISSIPPI DEPARTMENT OF NATURAL RESOURCES

Bureau of Land and Water Resources

Southport Mall

P.O. Box 10631

Jackson, Mississippi 39209

WATER WELL DRILLERS LOG

CODED

WARREN
A14
10/8/80

Oct. 8 1980 date well completed E.M. "Bud" Cresswell firm name Warren county well located

LANDOWNER: W. S. Hancock
Benton, MS. 39040
 (mailing address)

description of formations encountered	from	to
<u>gravel</u>	<u>0</u>	<u>10</u>
<u>hard gravel</u>	<u>10</u>	<u>140</u>

WELL LOCATION:
 sec. 26 T 18 N R 1 E
at Eagle Lake of
 (distance) miles (direction) (nearest town)

CODED

WELL PURPOSE: home
 (home, irrigation, municipal, industrial)

WELL COMPLETION DATA:

(1) diameter (inches) 4

(2) total depth (feet) 140

(3) static water level (feet) 15 below above top of ground.

(4) casing PVC 120
 (material) (depth)
4 if telescope see back.
 (size)

(5) screen 20 120
 (length) (depth to top)
4 PVC
 (size) (material)

(6) pump 1 20
 (HP) (yield gpm)
0
 (type power)

(7) electric log no
 (yes or no)

(organization running log)

(8) show well bottom plugged rain wash valve

DEPT. OF NATURAL RESOURCES
 BUREAU OF LAND & WATER RESOURCES


OCT 17 1980

RECEIVED

DRILLERS REMARKS:

If well telescopes please
sketch and show depths.

GROUND LEVEL

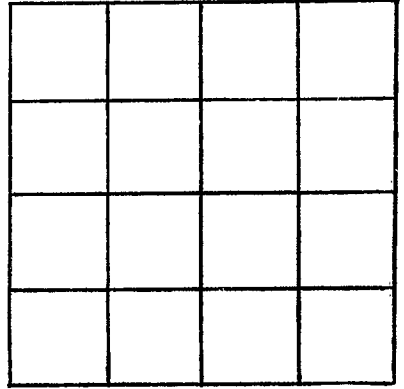

SECTION _____

Please indicate well location X.

ADDITIONAL INFORMATION

If more than one screen,
show locations of each on sketch.