

MISSISSIPPI DEPARTMENT OF NATURAL RESOURCES

Bureau of Land and Water Resources

Southport Mall

P.O. Box 10631

Jackson, Mississippi 39209

WATER WELL DRILLERS LOG

CODED

**WARREN**  
A16  
11-17-83  
Els #182

11/17/83 date well completed 19 83 Jack L. Quinn firm name Warren county well located

LANDOWNER: Henry Whitehead

description of formations encountered	from	to
<u>Sand &amp; gravel</u>	<u>0</u>	<u>190</u>
<u>Clay</u>	<u>190</u>	<u>420</u>
<u>Sand &amp; shell</u>	<u>420</u>	<u>760</u>

(mailing address)  
WELL LOCATION:  
sec. 5 T 16 N R. 2 E  
25 miles N of Wicksburg  
(distance) (direction) (nearest town)

WELL PURPOSE: Teaching club  
(home, irrigation, municipal, industrial)

CODED


- WELL COMPLETION DATA:
- (1) diameter (inches) 4 in
  - (2) total depth (feet) 760 610
  - (3) static water level (feet) 9 below top of ground.
  - (4) casing P.V.C. 760 640  
(material) (depth)  
4 in if telescope see back.  
(size)
  - (5) screen 30 640  
(length) (depth to top)  
4 in P.V.C.  
(size) (material)
  - (6) pump 3/4 10  
(HP) (yield gpm)  
Electric  
(type power)
  - (7) electric log yes  
(yes or no)  
M. J. S.  
(organization running log)
  - (8) how well bottom plugged back  
was value

DRILLERS REMARKS:

DEPT. OF NATURAL RESOURCES  
BUREAU OF LAND & WATER RESOURCES  
NOV 21 1983  
**RECEIVED**

If well telescopes please sketch and show depths.

GROUND LEVEL

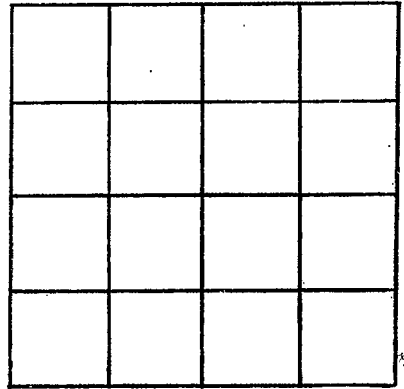

SECTION \_\_\_\_\_

Please indicate well location X.

ADDITIONAL INFORMATION

If more than one screen,  
show locations of each on sketch.