

MISSISSIPPI DEPARTMENT OF NATURAL RESOURCES

Bureau of Land and Water Resources

Southport Mall

P.O. Box 10631

Jackson, Mississippi 39209 **CODED**

WATER WELL DRILLERS LOG

**WARREN**  
**A17**  
**11-17-83**  
**Elev # 184**

11/17 1983 Jacke Quinn Water Well Drilling Warren  
date well completed firm name county well located

LANDOWNER:  
Steel Bayou Hunting Club  
(mailing address)

description of formations encountered	from	to
<u>Sand &amp; gravel</u>	<u>0</u>	<u>170</u>
<u>Clay</u>	<u>170</u>	<u>450</u>
<u>&amp; Sand</u>	<u>450</u>	<u>693</u>
	<u>693</u>	

WELL LOCATION:  
sec. 4 T 18N R 2E  
S W  
25 miles N of DeKalb  
(distance) (direction) (nearest town)

WELL PURPOSE: Hunting Club  
(home, irrigation, municipal, industrial)

- WELL COMPLETION DATA:
- (1) diameter (inches) 4 in.
  - (2) total depth (feet) 693 ft.
  - (3) static water level (feet) 10 below top of ground.
  - (4) casing P.V.C. 600ft.  
(material) (depth)  
4 in. if telescope see back.  
(size)
  - (5) screen 30ft 600ft.  
(length) (depth to top)  
4 in. P.V.C.  
(size) (material)
  - (6) pump 1 15  
(HP) (yield gpm)  
Electric  
(type power)
  - (7) electric log yes  
(yes or no)  
M. D. S.  
(organization running log)
  - (8) how well bottom plugged back  
wash valve

DRILLERS REMARKS:


DEPT. OF NATURAL RESOURCES  
BUREAU OF LAND & WATER RESOURCES

NOV 21 1983

**RECEIVED**

If well telescopes please sketch and show depths.

GROUND LEVEL

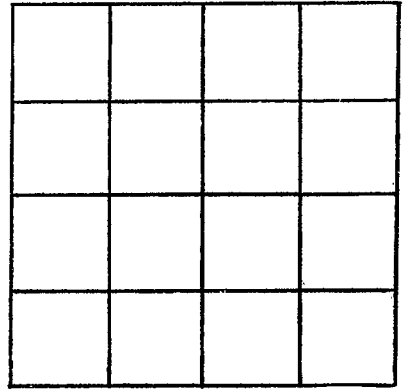

SECTION \_\_\_\_\_

Please indicate well location X.

ADDITIONAL INFORMATION

If more than one screen,  
show locations of each on sketch.