

WARREN
A 2000
6-9-62

WATER WELL DRILLERS LOG

Date: June 9, 1962, Driller: J H Barnes County Warren
(Name)

(1) Owner of Land: W F SCHMIDT
(Name)
TINSLEY MISS.
(Address)

(2) Location: 1/4, 1/4, Sec 21 T18R2E
14 miles N-W, of Vicksburg
(distance) (direction) (Nearest Town)

(3) Topography: FLAT
(Hilly) (Flat) (Level)

(4) Purpose of Well: Home use
(Domestic Irrigation
Municipal, Industrial, Other)

Description & Color of Materials Sand, Clay, Red Clay, Shell, etc.	Thick- ness Feet	Dep. Feet
<u>Delta Clay</u>	<u>15</u>	<u>15</u>
<u>Sand +</u>	<u>130</u>	<u>145</u>
<u>Gravel</u>	<u>10</u>	<u>155</u>
<u>Blue Clay</u>	<u>100</u>	<u>255</u>
<u>Light Grey Clay</u>	<u>75</u>	<u>330</u>
<u>Dark Shell</u>	<u>170</u>	<u>500</u>
<u>Sand</u>	<u>110</u>	<u>610</u>
<u>Shell</u>	<u>104</u>	<u>714</u>
<u>Rock</u>	<u>0</u>	<u>715</u>
<u>Sand</u>	<u>143</u>	<u>858</u>

Information upon completion of well:

(1) Diameter 4" inches.

(2) Total Depth 858 feet.

(3) Water Level 6 feet below top of ground.

(4) Cased to 838, Size 2"


(5) Screen: Size 0006, Length 10

(6) Were any formations sealed against pollution?
_____ yes, _____ no.

If YES depth of formation _____

Why _____

Drillers Remarks: _____

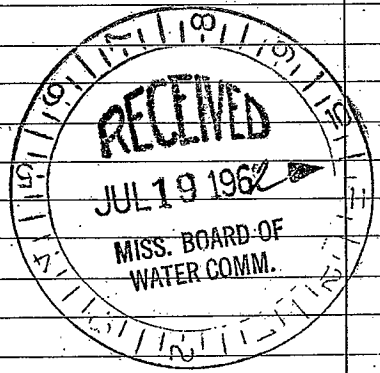

(Use Back Side)

Well No.

I was told that I did
not have to send in a log
on wells that was under 100 ft.

J. G. Barnes