

**WARREN**  
 A 2001  
 1-10-77

MISSISSIPPI  
 BOARD OF WATER COMMISSIONERS  
 416 North State Street  
 151 Jackson, Mississippi 39201

WATER WELL DRILLERS LOG

JAN. 10 1977 E. M. "Bud" CRESSWELL WARREN  
 date well completed firm name county well located

LANDOWNER: LEONARD CLARK  
 JACKSON, MS.  
 (mailing address)

description of formations encountered	from	to
CLAY	0	12
SAND-GRAVEL	12	85

WELL LOCATION:  
 sec. 14 T. 17 N. R. 21 E.  
 Steel Bayou  
 (distance) miles (direction) of (nearest town)

WELL PURPOSE: LAND  
 (home, irrigation, municipal, industrial)

- WELL COMPLETION DATA:
- (1) diameter (inches) 2
  - (2) total depth (feet) 85
  - (3) static water level (feet) 18 below above top of ground.
  - (4) casing PLASTIC 80  
 (material) (depth)
  - 2 if telescope see back.  
 (size)
  - (5) screen 5 80  
 (length) (depth to top)
  - 2 PLASTIC  
 (size) (material)
  - (6) pump 3/4 10  
 (HP) (yield gpm)
  - 0  
 (type power)
  - (7) electric log no  
 (yes or no)
  - 0  
 (organization running log)

(8) how well bottom plugged  
Steel plug


DRILLERS REMARKS: C

**RECEIVED**  
 FEB - 8 1977

MISS. BB. OF WATER COMM.

If well telescopes please sketch and show depths.

GROUND LEVEL

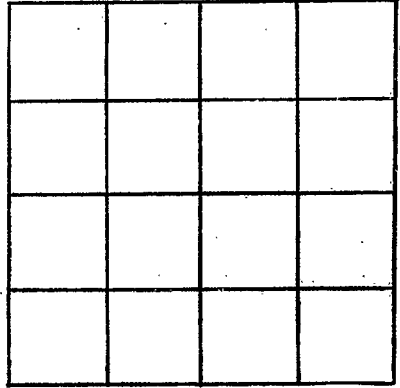

SECTION \_\_\_\_\_

Please indicate well location X.

ADDITIONAL INFORMATION

If more than one screen,  
show locations of each on sketch.