

WARREN
A 2000
7-14-77

MISSISSIPPI
BOARD OF WATER COMMISSIONERS
416 North State Street
157 Jackson, Mississippi 39201

WATER WELL DRILLERS LOG

July 14, 1977 19 77 date well completed
E.M. "Bud" CRESSWELL firm name
WARREN county well located

LANDOWNER:
Hook and Hound
Vicksburg, Ms.
(mailing address)

description of formations encountered	from	to
Clay	0	40
Sand	40	120

WELL LOCATION:
sec. 31 T 18 N R 2 E
At Eagle LAKE
(distance) miles (direction) of (nearest town)

WELL PURPOSE: CAMP
(home, irrigation, municipal, industrial)

- WELL COMPLETION DATA:
- (1) diameter (inches) 4
 - (2) total depth (feet) 120
 - (3) static water level (feet) 20 below top of ground.
 - (4) casing PVC (material), 110 (depth)
4 (size) if telescope see back.
 - (5) screen 10 (length), 110 (depth to top)
4 (size), PVC (material)
 - (6) pump 1 (HP), 30 (yield gpm)
0 (type power)
 - (7) electric log No (yes or no)
0 (organization running log)


(8) how well bottom plugged
Steel Plug

DRILLERS REMARKS:

RECEIVED
AUG 12 1977

If well telescopes please sketch and show depths.

GROUND LEVEL

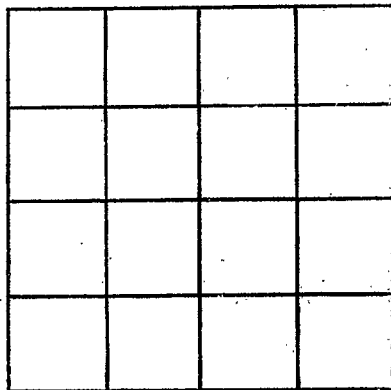

SECTION _____

Please indicate well location X.

ADDITIONAL INFORMATION

If more than one screen, show locations of each on sketch.