

WARREN
A 2003
6/18/79

MISSISSIPPI
BOARD OF WATER COMMISSIONERS
416 North State Street
Jackson, Mississippi 39201

WATER WELL DRILLERS LOG

6/18/79 date well completed
T. E. M. "Bud" Cresswell firm name
WARREN county well located

LANDOWNER:
Dale Maxwell
Vicksburg MS.
(mailing address)

description of formations encountered	from	to
Clay	0	30
Sand-gravel	30	100

WELL LOCATION:
sec 31 T 18 N R 2 E
Eagle Lake miles of
(distance) (direction) (nearest town)

WELL PURPOSE: home
(home, irrigation, municipal, industrial)

WELL COMPLETION DATA:
(1) diameter (inches) 4
(2) total depth (feet) 100
(3) static water level (feet) 2 below top of ground.
(4) casing PVC 80 (material) (depth)
4 (size) if telescope see back.
(5) screen 20 80 (length) (depth to top)
4 PVC (size) (material)
(6) pump None 40 (HP) (yield gpm)
(type power)
(7) electric log No (yes or no)
(organization running log)

(8) how well bottom plugged
Steel tubing

DRILLERS REMARKS:


Miss. Board of Water Comm.

JUL 5 1979

RECEIVED

If well telescopes please sketch and show depths.

GROUND LEVEL

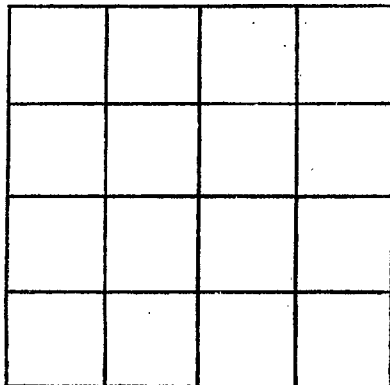

SECTION _____

Please indicate well location X.

ADDITIONAL INFORMATION

If more than one screen, show locations of each on sketch.