

MISSISSIPPI DEPARTMENT OF NATURAL RESOURCES

Bureau of Land and Water Resources

Southport Mall

P.O. Box 10631

Jackson, Mississippi 39209

WATER WELL DRILLERS LOG

Warren  
A 2005

Oct. 25 1983  
date well completed

\$B E.M. Bud Cresswell  
firm name

Warren  
county well located

LANDOWNER:	description of formations encountered	from	to
Anderson-Talley Co. Vicksburg, MS. (mailing address)	Clay Sand - gravel	0	20 110
<b>WELL LOCATION:</b>			
sec. <u>8</u> T <u>17</u> N R. <u>2</u> E <u>2</u> miles <u>South</u> of <u>Leake Lake</u> (distance) (direction) (nearest town)			
<b>WELL PURPOSE:</b>			
(home, irrigation, municipal, industrial)	Camp		
<b>WELL COMPLETION DATA:</b>			
(1) diameter (inches) <u>4</u>			
(2) total depth (feet) <u>110</u>			
(3) static water level (feet) <u>10</u> below top of ground.			
(4) casing <u>PVC</u> , <u>100</u> , (material) (depth), <u>4</u> (size) if telescope see back.			
(5) screen <u>10</u> , <u>100</u> (length) (depth to top) <u>4</u> , <u>PVC</u> (size) (material)			
(6) pump <u>1</u> , <u>25</u> (HP) (yield gpm)  (type power)			
(7) electric log <u>No</u> (yes or no)  (organization running log)			
(8) how well bottom plugged <u>back with 1/2 value</u>			
<b>DRILLERS REMARKS:</b>			


DEPT. OF NATURAL RESOURCES  
BUREAU OF LAND & WATER RESOURCES

NOV 23 1983

RECEIVED

If well telescopes please sketch and show depths.

GROUND LEVEL

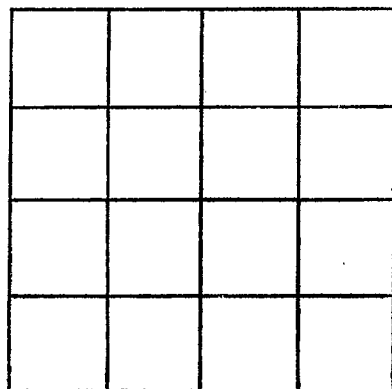

SECTION \_\_\_\_\_

Please indicate well location X.

ADDITIONAL INFORMATION

If more than one screen, show locations of each on sketch.