

Waver  
Assoce

MISSISSIPPI DEPARTMENT OF NATURAL RESOURCES  
Bureau of Land and Water Resources  
Southport Mall  
P.O. Box 10631  
Jackson, Mississippi 39209  
WATER WELL DRILLERS LOG

11/17 1983 Jack C. Quinn waver  
date well completed firm name county well located

LANDOWNER: Major  
  
(mailing address)

description of formations encountered	from	to
Sand & gravel	0	190
Clay	190	420
Sand & shell	420	760

WELL LOCATION:  
sec 5 T 18 N R 2 E  
S W  
25 miles N of Wicksburg  
(distance) (direction) (nearest town)

WELL PURPOSE: Hunting Club  
(home, irrigation, municipal) industrial

- WELL COMPLETION DATA:
- (1) diameter (inches) 4 in.
  - (2) total depth (feet) 760
  - (3) static water level (feet) 9 below above top of ground.
  - (4) casing P.V.C., 640,  
(material) (depth)  
4 in. if telescope see back.  
(size)
  - (5) screen 30, 640  
(length) (depth to top)  
4 in., P.V.C.  
(size) (material)
  - (6) pump 3/4, 10  
(HP) (yield gpm)
  - (7) electric log yes (No E log)  
(type power)  
MA  
(organization running log)
  - (8) how well bottom plugged back  
wash valve


DRILLERS REMARKS:

DEPT. OF NATURAL RESOURCES  
BUREAU OF LAND & WATER RESOURCES

NOV 21 1983  
RECEIVED

If well telescopes please sketch and show depths.

GROUND LEVEL

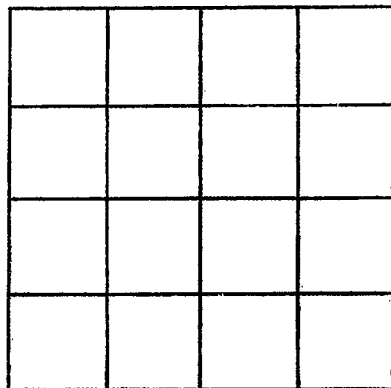

SECTION \_\_\_\_\_

Please indicate well location X.

ADDITIONAL INFORMATION

If more than one screen,  
show locations of each on sketch.