

MISSISSIPPI DEPARTMENT OF NATURAL RESOURCES

Bureau of Land and Water Resources

Southport Mall

P.O. Box 10631

Jackson, Mississippi 39209

WATER WELL DRILLERS LOG

Warren  
A  
2007

Aug. 27 1984  
 date well completed

84 E.M. Bud Cresswell  
 firm name

Warren  
 county well located


LANDOWNER:	description of formations encountered	from	to
<u>Jim Vickers</u> <u>Vicksburg, MS.</u> (mailing address)	<u>clay</u> <u>sand gravel</u>	<u>0</u> <u>35</u>	<u>35</u> <u>120</u>
WELL LOCATION: sec <u>13</u> T <u>17</u> N R <u>2</u> E <u>2</u> miles <u>North</u> of <u>Jackson</u> (distance) (direction) (nearest town)			
WELL PURPOSE: <u>None</u> (home, irrigation, municipal, industrial)			
WELL COMPLETION DATA:			
(1) diameter (inches) <u>2</u>			
(2) total depth (feet) <u>120</u>			
(3) static water level (feet) <u>25</u> below top of ground.			
(4) casing <u>PVC</u> , <u>110</u> (material) (depth) <u>2</u> (size) If telescope see back.			
(5) screen <u>10</u> , <u>110</u> (length) (depth to top) <u>2</u> , <u>PVC</u> (size) (material)			
(6) pump <u>none</u> (HP) (yield gpm) (type power)			
(7) electric log <u>no</u> (yes or no) (organization running log)			
(8) how well bottom plugged <u>and plug</u>			
DRILLERS REMARKS:			

DEPT. OF NATURAL RESOURCES  
 BUREAU OF LAND & WATER RESOURCES

SEP 24 1984  
 RECEIVED

If well telescopes please sketch and show depths.

GROUND LEVEL

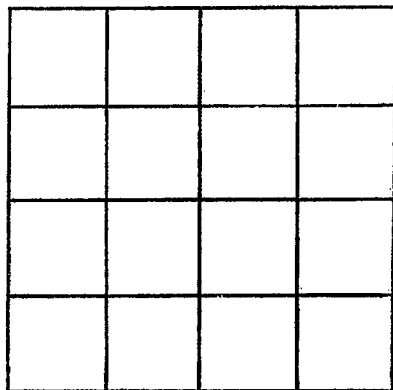

SECTION \_\_\_\_\_

Please indicate well location X.

ADDITIONAL INFORMATION

If more than one screen, show locations of each on sketch.