

MISSISSIPPI DEPARTMENT OF NATURAL RESOURCES

Bureau of Land and Water Resources

Southport Mall

P.O. Box 10631

Jackson, Mississippi 39209

WATER WELL DRILLERS LOG

WARREN
A 3002

Aug. 13
date well completed

86 E.M. Bud Cresswell
firm name

WARREN
county well located

LANDOWNER: Well No. 2
Browns Point Assn.
Vicksburg, MS.
(mailing address)

description of formations encountered	from	to
Surface	0	18
Sand gravel	18	120

WELL LOCATION: 17-28
sec 35 T 18 N R 1 E
Kings Point Island
(distance) miles (direction) of (nearest town)

WELL PURPOSE: Camp
(home, irrigation, municipal, industrial)

- WELL COMPLETION DATA:
- (1) diameter (inches) 4
 - (2) total depth (feet) 120
 - (3) static water level (feet) 18 below above top of ground
 - (4) casing PVC 100 (material) (depth)
4 (size) if telescope see back.
 - (5) screen 20 100 (length) (depth to top)
4 PVC (size) (material)
 - (6) pump 1 20 (HP) (yield gpm)
(type power)
 - (7) electric log No (yes or no)
(organization running log)
 - (8) how well bottom plugged
back wash

RECEIVED


AUG 26 1986

Department of Natural Resources
Bureau of Land & Water Resources

DRILLERS REMARKS:

If well telescopes please sketch and show depths.

GROUND LEVEL

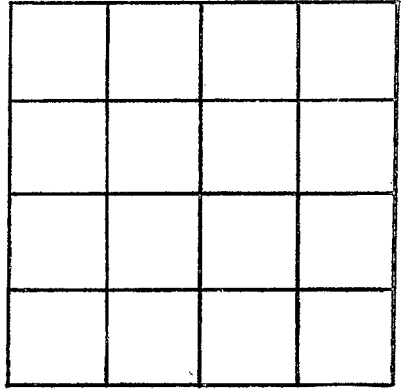

SECTION _____

Please indicate well location X.

ADDITIONAL INFORMATION

If more than one screen,
show locations of each on sketch.