

MISSISSIPPI DEPARTMENT OF NATURAL RESOURCES

Bureau of Land and Water Resources

Southport Mall

P.O. Box 10631

Jackson, Mississippi 39209

WATER WELL DRILLERS LOG

WARREN
A 2009

Oct. 20 1988

E.M. Bud Cresswell

Warren

date well completed

firm name

county well located

LANDOWNER:	description of formations encountered	from	to
Ray Wright Vicksburg, MS. (mailing address)	surface sand gravel	0	60 110
<p>WELL LOCATION:</p> <p>sec. <u>24</u> T <u>18</u> N R <u>2</u> E</p> <p><u>5</u> miles <u>NW</u> of <u>Redwood</u></p> <p>(distance) (direction) (nearest town)</p>			
<p>WELL PURPOSE: <u>Camp</u></p> <p>(home, irrigation, municipal, industrial)</p>			
<p>WELL COMPLETION DATA:</p> <p>(1) diameter (inches) <u>4</u></p> <p>(2) total depth (feet) <u>110</u></p> <p>(3) static water level (feet) <u>15</u> below top of ground.</p> <p>(4) casing <u>PVC</u> <u>90</u> (material) (depth)</p> <p><u>4</u> if telescope see back. (size)</p> <p>(5) screen <u>20</u> <u>90</u> (length) (depth to top)</p> <p><u>4</u> <u>PVC</u> (size) (material)</p> <p>(6) pump <u>1</u> <u>20</u> (HP) (yield gpm)</p> <p>(type power) _____</p> <p>(7) electric log <u>no</u> (yes or no)</p> <p>(organization running log) _____</p> <p>(8) how well bottom plugged: <u>Sand Check</u></p>			
<p>DRILLERS REMARKS:</p>			


RECEIVED

NOV 2 1988

Department of Natural Resources
Bureau of Land & Water Resources

If well telescopes please sketch and show depths.

GROUND LEVEL

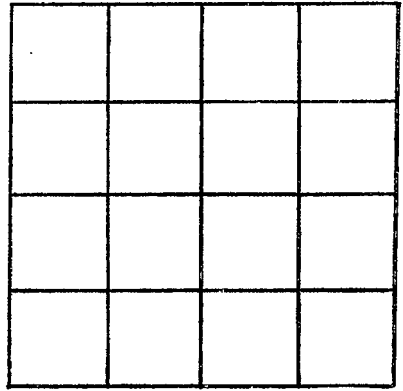

SECTION _____

Please indicate well location X.

ADDITIONAL INFORMATION

If more than one screen,
show locations of each on sketch.