

WARREN

B

11-24-61

WATER WELL DRILLERS LOG

B

Warren
Cyprien

Date: 11-24-19 61 Driller:

Butch
(Name)

County

(1) Owner of Land: Louis Moore
(Name)

Veckelby Drive
(Address)

(2) Location: 1/4, 1/4, Sec. T R

1 1/2 miles W of
(distance) (direction) (Nearest Town)

(3) Topography: Valley Ridge
(Hilly) (Flat) (Level)

(4) Purpose of Well: Domestic
(Domestic Irrigation, Municipal, Industrial, Other)

Description & Color of Materials
Sand, Clay, Red Clay, Shell, etc.

Thick-
ness
Feet

Depth-
Feet

0-76 clay
76-100 yellow sand

Information upon completion of well:

(1) Diameter 7 inches.

(2) Total Depth 100 feet.

(3) Water Level 80 feet below top of ground.

(4) Cased to 100, Size 2

(5) Screen: Size 106 Length 5


(6) Were any formations sealed against pollution?

yes, no.

If YES depth of formation

Why

Drillers Remarks:

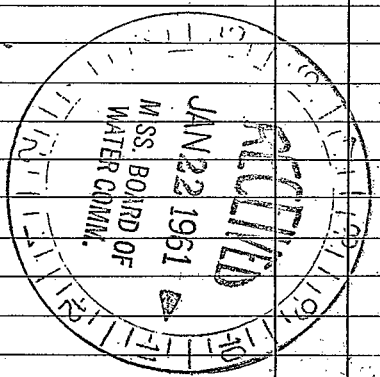

Well No.

(Use Back Side)

