

B
2-22-62

WATER WELL DRILLERS LOG

Date: 2-22 19 62 Driller: Blush County: Warren
(Name)

(1) Owner of Land: W.D. Windham
(Name)
Palmer, Miss
(Address)

(2) Location: 1/4, 1/4, Sec. T R R
2 miles NW 1/4 of Palmer
(distance) (direction) (Nearest Town)

(3) Topography: Level
(Hilly) (Flat) (Level)

(4) Purpose of Well: Home
(Domestic Irrigation
Municipal, Industrial, Other)

Description & Color of Materials Sand, Clay, Red Clay, Shell, etc.	Thick- ness Feet	Depth Feet
<u>0-31 Red clay</u>		
<u>31-39 fine shell</u>		
<u>39-140 shell</u>		
<u>140-145 blue sand</u>		
<u>145-159 clay</u>		
<u>159-166 Blue sand</u>		

Information upon completion of well:

(1) Diameter 2 inches.

(2) Total Depth 166 feet.

(3) Water Level 82 feet below top of ground.

(4) Cased to 166, Size 2


(5) Screen: Size 2, Length 5

(6) Were any formations sealed against pollution?
_____ yes, _____ no.

If YES depth of formation _____

Why _____

Drillers Remarks: _____

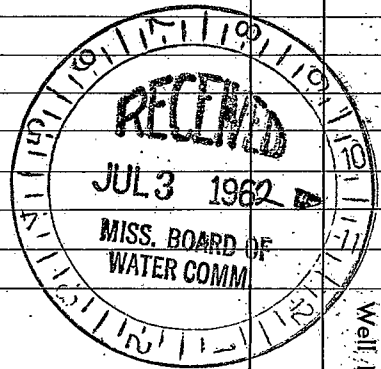

Well No.

(Use Back Side)

