

Warren  
B 5  
11-67

**MISSISSIPPI  
BOARD OF WATER COMMISSIONERS**  
416 North State Street  
Jackson, Mississippi 39201

**WATER WELL DRILLERS LOG**

Nov. 19 67 Hall Drilling Co. Warren  
date well completed                      firm name                      county well located

LANDOWNER: Allied Chemical Co.  
Redwood, Miss.  
(mailing address)


WELL LOCATION:  
sec. 13 T18 N      R 4 E  
10 miles N of Vicksburg  
(distance)      (direction)      (nearest town)

WELL PURPOSE: INDUSTRIAL  
(home, irrigation, municipal, industrial)

description of formations encountered	from      to	
<u>Surface Soil</u>	<u>0</u>	<u>10</u>
<u>Shale</u>	<u>10</u>	<u>50</u>
<u>Rock</u>	<u>50</u>	<u>54</u>
<u>Soft Sand Stone</u>	<u>54</u>	<u>84</u>
<u>Gray Sand</u>	<u>85</u>	<u>225</u>
<u>Yazoo Clay</u>	<u>225</u>	<u>682</u>
<u>Moody Branch Clay</u>	<u>682</u>	<u>700</u>
<u>Clay</u>	<u>700</u>	<u>760</u>
<u>Gray Sand</u>	<u>760</u>	<u>780</u>
<u>Sand &amp; Shale Sand</u>	<u>780</u>	<u>821</u>
<u>Sand</u>	<u>821</u>	<u>826</u>
<u>Clay &amp; Sand</u>	<u>826</u>	<u>830</u>
<u>Sand</u>	<u>830</u>	<u>841</u>

- WELL COMPLETION DATA:
- (1) diameter (inches) 6 x 4
  - (2) total depth (feet) 841
  - (3) static water level (feet) 12 below above top of ground.
  - (4) casing STEEL (material), (depth), 6" x 4" (size) if telescope see back.
  - (5) screen 30' (length), 821 (depth to top), 4" (size), STAINLESS STEEL (material)
  - (6) pump 7 1/2 (HP), 50 (yield gpm), ELECTRIC (type power)
  - (7) electric log yes (yes or no), WSG & STATE (organization running log)
  - (8) how well bottom plugged backwash valve

DRILLERS REMARKS:

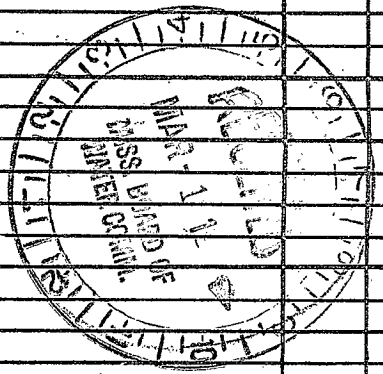


(X)

If well telescopes please sketch and show depths.

B5 W 4221

GROUND LEVEL

252' - 6"

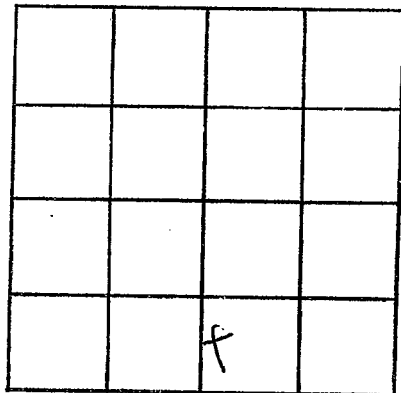

SECTION 13

Please indicate well location X.

ADDITIONAL INFORMATION

E-Log to 851

Gravel Intervals 814-822  
 830-832  
 838-849  
 2W

Screened 817-834 20  
 832-848 10  
 2W

If more than one screen, show locations of each on sketch.