

WARREN  
B12  
2-3-71

MISSISSIPPI  
BOARD OF WATER COMMISSIONERS  
416 North State Street  
Jackson, Mississippi 39201

**CODED**

WATER WELL DRILLERS LOG

Feb-3

1971 E.M. "Bud" Cresswell

WARREN

date well completed

firm name

county well located

LANDOWNER:

Anderson-Tulley Co.  
Vicksburg, Miss.  
(mailing address)

description of formations  
encountered

from

to

Clay  
Sandy-gravel

0 10  
10 89

WELL LOCATION:

sec. 7 T-8 N R-4 E  
5 miles West of Redwood  
(distance) (direction) (nearest town)

WELL PURPOSE: Domestic  
(home, irrigation, municipal, industrial)

WELL COMPLETION DATA:

- (1) diameter (inches) 2
- (2) total depth (feet) 89
- (3) static water level (feet) 10 below  
top of ground. above
- (4) casing steel 84  
(material) (depth)  
2"  
(size) If telescope see back.
- (5) screen 5ft. 84  
(length) (depth to top)  
2" Stainless  
(size) (material)
- (6) pump None  
(HP) (yield gpm)  
0  
(type power)
- (7) electric log No  
(yes or no)  
0  
(organization running log)

**CODED**


FEB 22 1971

DRILLERS REMARKS: Steel plug

MISS. BD. OF  
WATER COMM.

If well telescopes please sketch and show depths.

GROUND LEVEL

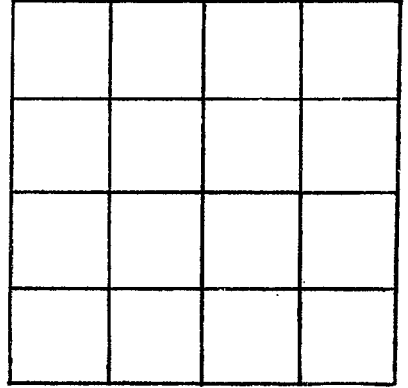

SECTION \_\_\_\_\_

Please indicate well location X.

ADDITIONAL INFORMATION

If more than one screen,  
show locations of each on sketch.