

MISSISSIPPI  
BOARD OF WATER COMMISSIONERS  
416 North State Street  
Jackson, Mississippi 39201

**CODED**

WATER WELL DRILLERS LOG

Feb 4

1971

W. E. M. "Bud" Cresswell

Warren

date well completed

firm name

county well located

LANDOWNER:

Anderson-Talley Co.  
Hicksburg, Miss.  
(mailing address)

description of formations encountered

from

to

Clay  
sand & gravel

0 12  
12 89

WELL LOCATION:

sec. 7 T 8 N R 4 E  
5 miles West of Redwood  
(distance) (direction) (nearest town)

WELL PURPOSE: water  
(home, irrigation, municipal, industrial)

WELL COMPLETION DATA:

- (1) diameter (inches) 2
- (2) total depth (feet) 89
- (3) static water level (feet) 12 below above top of ground.
- (4) casing steel 84  
(material) (depth)  
2"  
(size) if telescope see back.
- (5) screen 5ft. 84ft.  
(length) (depth to top)  
2" stainless  
(size) (material)
- (6) pump None  
(HP) (yield gpm)  
0  
(type power)
- (7) electric log 0  
(yes or no)  
0  
(organization running log)

**CODED**

FEB 22 1971


DRILLERS REMARKS:

steel plug

MISS. BD. OF  
WATER COMMA.

If well telescopes please  
sketch and show depths.

GROUND LEVEL

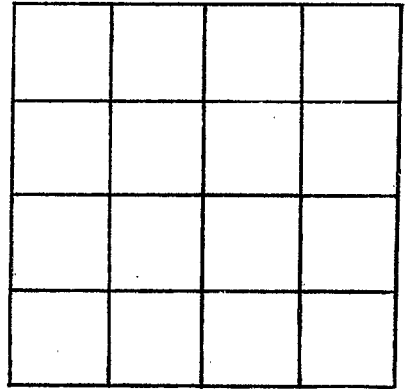

SECTION \_\_\_\_\_

Please indicate well location X.

ADDITIONAL INFORMATION

If more than one screen,  
show locations of each on sketch.