

WARREN

MISSISSIPPI BOARD OF WATER COMMISSIONERS

B14

9-10-60

WATER WELL DRILLERS LOG

CODED

Date: 9-10, 1960, Driller: P. [Signature]

County: Warren

(Name)

(1) Owner of Land: Ralph [Signature]
 (Name)
Redwood [Signature]
 (Address)

(2) Location: 1/4, 1/4, Sec. 26-18-4
2 miles N. of Redwood
 (distance) (direction) (Nearest Town)

(3) Topography: Hilly
 (Hilly) (High) (Level)

(4) Purpose of Well: Stock
 (Domestic Irrigation
 Municipal, Industrial, Other)

Description & Color of Materials Sand, Clay, Red Clay, Shell, etc.	Thick- ness Feet	Depth Feet
0-22 clay		
22-60 clay and stone		
60-119 clay		
119-131 sand		
131-141 clay		

Information upon completion of well:

(1) Diameter 4 inches.

(2) Total Depth 141 feet.

(3) Water Level 72 feet below top of ground.

(4) Cased to 141, Size 4

(5) Screen: Size 3, Length 20


(6) Were any formations sealed against pollution?
 _____ yes, NO no.

CODED

If YES depth of formation _____

Why _____

Drillers Remarks: _____

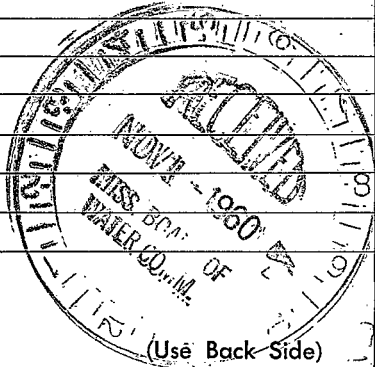

Well No.

