

WARREN
B15
6-19-71

MISSISSIPPI
BOARD OF WATER COMMISSIONERS
416 North State Street
Jackson, Mississippi 39201

CODED

WATER WELL DRILLERS LOG

June 19 1971 Felli "Bud" Crisswell Warren
date well completed firm name county well located

LANDOWNER:
J.B. Cagn
Pelwood, Miss.
(mailing address)

description of formations encountered	from	to
	Clay sand-gravel	0 15

WELL LOCATION:
sec. 18 T 18 N R 4 E
4 miles West of Pelwood
(distance) (direction) (nearest town)

WELL PURPOSE: Home
(home, irrigation, municipal, industrial)

WELL COMPLETION DATA:

(1) diameter (inches) 2

(2) total depth (feet) 68

(3) static water level (feet) 18 below top of ground.

(4) casing Steel 63 (material) (depth)
2 (size) if telescope see back.

(5) screen 5 63 (length) (depth to top)
2" (size) Stainless (material)

(6) pump 3/4 10 (HP) (yield gpm)
0 (type power)

(7) electric log No (yes or no)
(organization running log)

CODED

(8) how well bottom plugged
Steel plug


DRILLERS REMARKS:

JUL 6 1971

MISS. BD. OF
WATER COM.

If well telescopes please
sketch and show depths.

GROUND LEVEL

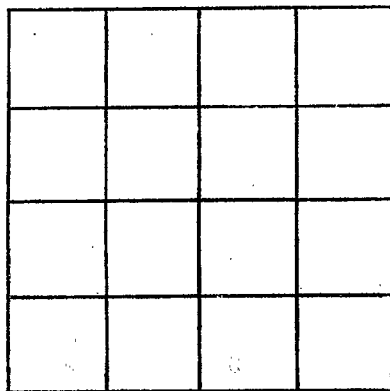

SECTION _____

Please indicate well location X.

ADDITIONAL INFORMATION

If more than one screen,
show locations of each on sketch.