

WARREN

B-16

7-23-71

CODED

MISSISSIPPI BOARD OF WATER COMMISSIONERS
16 North State Street
Jackson, Mississippi 39201

CODED

WATER WELL DRILLERS LOG

7-23
date well completed

71 E.M. "Bud" Crosswell
firm name

Warren
county well located

LANDOWNER:
Mrs. E. Heard
Relwood, Miss-
(mailing address)

description of formations encountered	from	to
	Clay Sand	0 60

WELL LOCATION:
sec. 16 T 18 N R 4 E
4 miles N of Relwood
(distance) (direction) (nearest town)

WELL PURPOSE: Domestic
(home, irrigation, municipal, industrial)

- WELL COMPLETION DATA:
- (1) diameter (inches) 2
 - (2) total depth (feet) 110
 - (3) static water level (feet) 18 below top of ground
 - (4) casing Steel 105 (material) (depth)
2" (size) if telescope see back.
 - (5) screen 5' 105 (length) (depth to top)
2" (size) (material) standard
 - (6) pump 0 20 (HP) (yield gpm)
0 (type power)
 - (7) electric log 0 (yes or no)
0 (organization running log)
 - (8) how well bottom plugged
Steel plug

CODED


AUG 18 1971

MISS. Bd. OF WATER COM.

DRILLERS REMARKS:

If well telescopes please sketch and show depths.

GROUND LEVEL

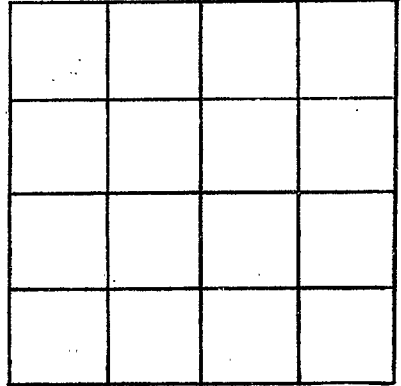

SECTION _____

Please indicate well location X.

ADDITIONAL INFORMATION

If more than one screen, show locations of each on sketch.