

WARREN

B-17

7-30-71

CODED

MISSISSIPPI BOARD OF WATER COMMISSIONERS
416 North State Street
Jackson, Mississippi 39201

CODED

WATER WELL DRILLERS LOG

7-30
date well completed

1971 E.M. "Bud" Crumwell
firm name

Warren
county well located

LANDOWNER:
A. E. Verwell
Redwood, Miss.
(mailing address)

description of formations encountered	from	to
	Clay sand	6 15

WELL LOCATION:
sec. 5 T. 18 N. R. 4 E
7 miles North of Redwood
(distance) (direction) (nearest town)

WELL PURPOSE: Stock
(home, irrigation, municipal, industrial)

WELL COMPLETION DATA:
(1) diameter (inches) 2
(2) total depth (feet) 68
(3) static water level (feet) 10 below top of ground.
(4) casing Steel 63
(material) (depth)
2"
(size) if telescope see back.
(5) screen 5 63
(length) (depth to top)
2" Stainless
(size) (material)
(6) pump 1/2 10
(HP) (yield gpm)
0
(type power)
(7) electric log 0
(yes or no)
(organization running log)

CODED


(8) how well bottom plugged
Steel plug
DRILLERS REMARKS:

AUG 18 1971

MISS. DIV. OF WATER CONTROL

If well telescopes please sketch and show depths.

GROUND LEVEL

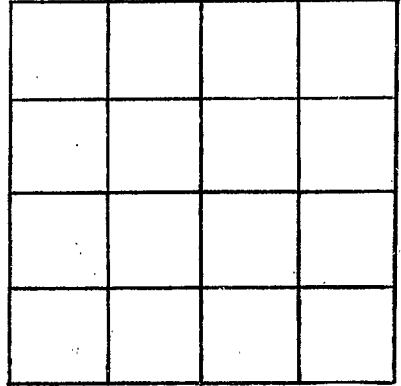

SECTION _____

Please indicate well location X.

ADDITIONAL INFORMATION

If more than one screen, show locations of each on sketch.