

WARREN
B 18
1-27-72

MISSISSIPPI
 BOARD OF WATER COMMISSIONERS
 416 North State Street
 Jackson, Mississippi 39201

CODED
 FEB 29 1972

WATER WELL DRILLERS LOG

Jan. 27 1972 date well completed
 E.M. "Bud" Cresswell firm name
 WARREN county well located

LANDOWNER:
 Albert Dornbusch
 Vicksburg, Miss.
 (mailing address)

description of formations encountered	from	to
Clay	0	15
Sand - gravel	15	160
Clay	160	680
Shale	680	760
Sand	760	846

WELL LOCATION:
 sec. 5 T. 18 N R. 4 E
8 miles North of Redwood
 (distance) (direction) (nearest town)

WELL PURPOSE: FARM
 (home, irrigation, municipal, industrial)


- WELL COMPLETION DATA:
- diameter (inches) 4
 - total depth (feet) 860
 - static water level (feet) 4 below top of ground
 - casing steel 840
 (material) (depth)
4 If telescope see back.
 (size)
 - screen 20 840
 (length) (depth to top)
2" stainless
 (size) (material)
 - pump 1 20
 (HP) (yield gpm)
0
 (type power)
 - electric log NO
 (yes or no)
0
 (organization running log)
 - how well bottom plugged
steel plug

CODED

DRILLERS REMARKS:

If well telescopes please sketch and show depths.

GROUND LEVEL

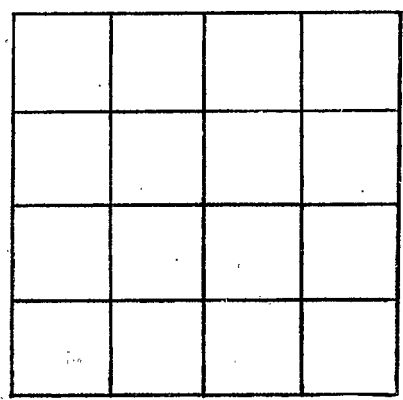

SECTION: _____

Please indicate well location X.

ADDITIONAL INFORMATION

A series of horizontal lines for recording additional information, starting below the 'ADDITIONAL INFORMATION' header and extending to the bottom of the page.

If more than one screen, show locations of each on sketch.