

WARREN
B19
2-1-72

MISSISSIPPI
 BOARD OF WATER COMMISSIONERS
 416 North State Street
 Jackson, Mississippi 39201

FEB 25 1972
CODED

WATER WELL DRILLERS LOG

Feb - 1 1972
 date well completed

E. M. "Bud" Cresswell
 firm name


WARREN
 county well located

LANDOWNER:	description of formations encountered	from	to
Louis Johnson Redwood, Miss. (mailing address)			
WELL LOCATION:			
sec. <u>9</u> T. <u>18</u> N. R. <u>4</u> E <u>7</u> miles <u>North</u> of <u>Redwood</u> (distance) (direction) (nearest town)			
WELL PURPOSE: <u>Domestic</u> (home, irrigation, municipal, industrial)			
WELL COMPLETION DATA:			
(1) diameter (inches) <u>2</u>			
(2) total depth (feet) <u>89</u>			
(3) static water level (feet) <u>20</u> below top of ground.			
(4) casing <u>Steel</u> , <u>84</u> (material) (depth)			
<u>2</u> if telescope see back. (size)			
(5) screen <u>5</u> , <u>84</u> (length) (depth to top)			
<u>2</u> , <u>Strainer</u> (size) (material)			
(6) pump <u>3/4</u> , <u>5</u> (HP) (yield gpm)			
<u>0</u> (type power)			
(7) electric log <u>No</u> (yes or no)			
<u>0</u> (organization running log)			
(8) how well bottom plugged <u>slut plug</u>			
DRILLERS REMARKS:			

CODED

If well telescopes please sketch and show depths.

GROUND LEVEL

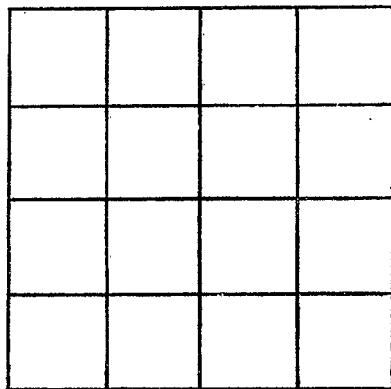

SECTION _____

Please indicate well location X.

ADDITIONAL INFORMATION

If more than one screen, show locations of each on sketch.