

WARREN
B 22
5-12-72

MISSISSIPPI
 BOARD OF WATER COMMISSIONERS
 416 North State Street
 Jackson, Mississippi 39201

WATER WELL DRILLERS LOG

CODED

MAY 12 19 72 E.M. "Bud" Cresswell WARREN
 date well completed firm name county well located

LANDOWNER:	description of formations encountered	from	to
<u>ANDERSON-TULLY</u> <u>DICKSBURG, MISS.</u> (mailing address)			
WELL LOCATION:			
sec. <u>7-18</u> N <u>4</u> E <u>6</u> miles <u>NW</u> of <u>Redwood</u> (distance) (direction) (nearest town)			
WELL PURPOSE: <u>FARM</u> (home, irrigation, municipal, industrial)			
WELL COMPLETION DATA:			
(1) diameter (inches) <u>2</u>			
(2) total depth (feet) <u>74</u>			
(3) static water level (feet) <u>18</u> below top of ground. above			
(4) casing <u>Steel</u> , <u>84</u> (material) (depth)			
<u>2</u> if telescope see back. (size)			
(5) screen <u>10</u> , <u>84</u> (length) (depth to top)			
<u>2"</u> , <u>Stainless</u> (size) (material)			
(6) pump <u>None</u> , <u>0</u> (HP) (yield gpm)			
<u>0</u> (type power)			
(7) electric log <u>No</u> (yes or no)			
(organization running log)			
(8) how well bottom plugged <u>Steel plug</u>			
DRILLERS REMARKS:			


CODED

MAY 25 1972

MISS. BD. OF
 WATER CONTROL

If well telescopes please sketch and show depths.

GROUND LEVEL

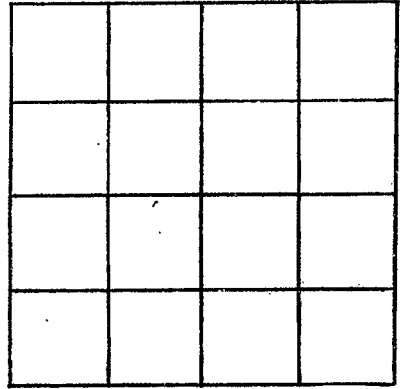

SECTION _____

Please indicate well location X.

ADDITIONAL INFORMATION

If more than one screen,
show locations of each on sketch.