

WARREN
B24
12
1-11-12

MISSISSIPPI
BOARD OF WATER COMMISSIONERS
416 North State Street
Jackson, Mississippi 39201

CODED

WATER WELL DRILLERS LOG

R JACK FURN'S WARREN

date well completed

firm name

county well located

LANDOWNER:

DAVE CATTIN

description of formations encountered

from

to

CLAY SAND

9 20
20 141

(mailing address)

WELL LOCATION:

sec 29 T 16 N R 4 E
2 miles W of Redwood
(distance) (direction) (nearest town)

WELL PURPOSE:

(home, irrigation, municipal, industrial)

WELL COMPLETION DATA:

- (1) diameter (inches) 4"
- (2) total depth (feet) 141
- (3) static water level (feet) 20 below top of ground.
- (4) casing (material) TDC, (depth) 126, (size) 4" if telescope see back.
- (5) screen (length) 15, (depth to top) 126, (size) 2", (material) SS
- (6) pump (HP) 1, (yield gpm) 10, (type power) REA
- (7) electric log (yes or no) YES, (organization running log) USGS
- (8) how well bottom plugged 1300 V


CODED

DRILLERS REMARKS:

MISSISSIPPI BOARD OF WATER COMMISSIONERS

If well telescopes please sketch and show depths.

GROUND LEVEL

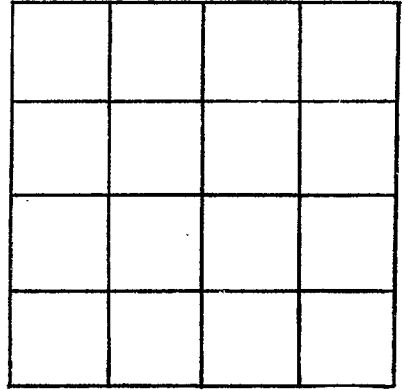

SECTION _____

Please indicate well location X.

ADDITIONAL INFORMATION

If more than one screen,
show locations of each on sketch.