

WARREN
B 28
10-31-73

MISSISSIPPI
 BOARD OF WATER COMMISSIONERS
 416 North State Street
 Jackson, Mississippi 39201

CODED

WATER WELL DRILLERS LOG

Oct. 31
 date well completed

1973 E.M. "Bud" Cresswell
 firm name

WARREN
 county well located

LANDOWNER:
 Don Daniels
 Vicksburg, Miss.
 (mailing address)

description of formations encountered	from	to
	Clay	0
SAND-GRAVEL	40	110

WELL LOCATION:
 sec. 33 T. 18 N. R. 4 E.
 2 miles NW of Redwood
 (distance) (direction) (nearest town)

WELL PURPOSE: DOMESTIC
 (home, irrigation, municipal, industrial)

WELL COMPLETION DATA:

- (1) diameter (inches) 2
- (2) total depth (feet) 110
- (3) static water level (feet) 19 below above top of ground.
- (4) casing Steel, 105,
 (material) (depth)
2 if telescope see back.
 (size)
- (5) screen 5, 105
 (length) (depth to top)
2, STAINLESS
 (size) (material)
- (6) pump NONE 10
 (HP) (yield gpm)
0
 (type power)
- (7) electric log No
 (yes or no)
0
 (organization running log)
- (8) how well bottom plugged
Steel plug

CODED


REC - 3 1173

DRILLERS REMARKS:

MISS. BD. OF
 WATER COMMISSIONERS

If well telescopes please sketch and show depths.

GROUND LEVEL

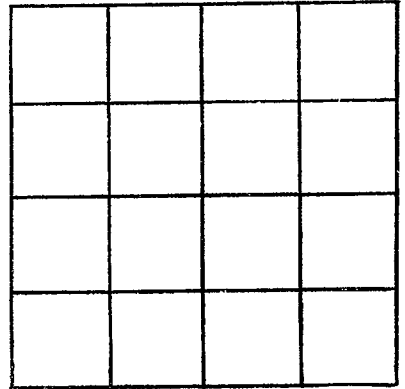

SECTION _____

Please indicate well location X.

ADDITIONAL INFORMATION

If more than one screen,
show locations of each on sketch.