

WARREN

B29

7-30-76

Log # 140

July 30 1976
date well completed

MISSISSIPPI
BOARD OF WATER COMMISSIONERS
416 North State Street
Jackson, Mississippi 39201

WATER WELL DRILLERS LOG

CODED

1976 E.M. "Bud" CRESSWELL
firm name

WARREN
county well located

LANDOWNER:

W.J. Thigpen

Red Wood, Ms.
(mailing address)

WELL LOCATION:

sec. 8 T 18 N R 4 E
3 miles North of Redwood
(distance) (direction) (nearest town)

WELL PURPOSE: home
(home, irrigation, municipal, industrial)

WELL COMPLETION DATA:

- (1) diameter (inches) 4 x 2
- (2) total depth (feet) 810
- (3) static water level (feet) 3 below top of ground.
- (4) casing Steel 780 (material), (depth)
4 (size) if telescope see back.
- (5) screen 30 780 (length), (depth to top)
2 STAINLESS (size), (material)
- (6) pump 1 30 (HP), (yield gpm)
0 (type power)
- (7) electric log yes (yes or no)
USGS (organization running log)

(8) how well bottom plugged
Steel plug

description of formations encountered

from to

CLAY	0	25
Sand-gravel	25	185
CLAY	183	630
Sandy shale	630	690
Shale	690	720
Sand	720	810

CODED

RECEIVED


AUG 3 - 1976

DRILLERS REMARKS:

MISS. BD. OF WATER COMMISSIONERS

If well telescopes please sketch and show depths.

GROUND LEVEL

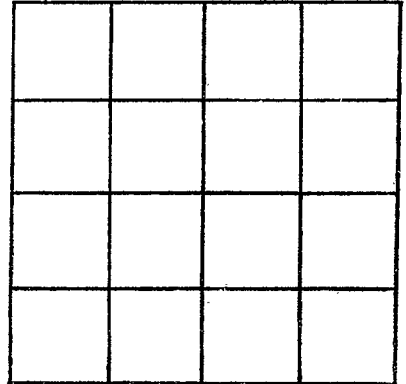

SECTION _____

Please indicate well location X.

ADDITIONAL INFORMATION

If more than one screen,
show locations of each on sketch.