

WARREN
B 36
9-11-79

MISSISSIPPI
 BOARD OF WATER COMMISSIONERS
 416 North State Street
 Jackson, Mississippi 39201

CODED WELL # /

WATER WELL DRILLERS LOG

September 11 19 79 Dreiling & Associates Warren
 date well completed firm name county well located

LANDOWNER:	description of formations encountered	from	to
Mr. Dan Wilkes			
(mailing address)	Soil & Clay	5	10
WELL LOCATION:	Clay	10	15
sec. 30 T 18(N) S R 4 E W	Clay	15	20
7.3 miles SE of V.P.	Clay	20	25
(distance) (direction) (nearest town)	Clay & Fine Sand	25	30
WELL PURPOSE: <u>irrigation</u>	Fine Sand	30	35
(home, irrigation, municipal, industrial)	Fine Sand	35	40
WELL COMPLETION DATA:	Fine Sand	40	45
(1) diameter (inches) <u>22"</u>	Fine Sand	45	50
(2) total depth (feet) <u>131'</u>	Fine Sand	50	55
(3) static water level (feet) <u>15'</u> (below/above top of ground)	Sand & Clay	55	60
(4) casing <u>steel</u> (<u>131'</u> (depth))	Sand & Clay	60	65
<u>16"</u> (size) if telescope see back.	Sand & Clay	65	70
(5) screen <u>40'</u> (<u>80'</u> (depth to top))	Sand	70	75
<u>16"</u> (size), <u>steel</u> (material)	Sand	75	80
(6) pump <u>60</u> (<u>2500</u> (yield gpm))	Sand	80	85
<u>Ind. engine</u> (type power)	Sand	85	90
(7) electric log <u>no</u> (yes or no)	Sand	90	95
<u>none</u> (organization running log)	Sand	95	100
(8) how well bottom plugged <u>clay</u>	Clay & Sand	100	105
DRILLERS REMARKS:	Clay & Sand	105	110
	Sand	110	115
	Sand & Clay	115	120
	Sand & Clay Gravel	120	125
	Sand & Gravel	125	130
	Clay		132

DEPT. OF NATURAL RESOURCES
 BUREAU OF LAND & WATER RESOURCES


OCT 11 1979

RECEIVED

X

If well telescopes please sketch and show depths.

GROUND LEVEL

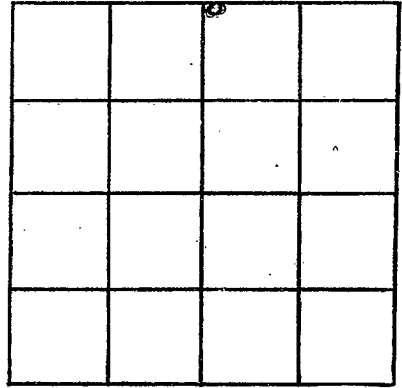

SECTION 30

Please indicate well location X.

ADDITIONAL INFORMATION

If more than one screen, show locations of each on sketch.