

WARREN  
B 38  
3-12-80

MISSISSIPPI  
BOARD OF WATER COMMISSIONERS  
416 North State Street  
Jackson, Mississippi 39201

CODED

WATER WELL DRILLERS LOG

MARCH 12 1980 E.M. "Bud" CRESSWELL WARREN  
date well completed firm name county well located

LANDOWNER:  
Mrs. J. D. Carr  
Vicksburg, Ms.  
(mailing address)

WELL LOCATION:  
sec. 7 T 18 N R 4 E  
5 miles North of Redwood  
(distance) (direction) (nearest town)

description of formations encountered	from to	
	from	to
Clay	0	30
Sand Gravel	30	170
Clay	170	620
Shale	620	720
Band	720	820

WELL PURPOSE: home  
(home, irrigation, municipal, industrial)

WELL COMPLETION DATA:

(1) diameter (inches) 4

(2) total depth (feet) 820

(3) static water level (feet) 4 below top of ground

(4) casing PVC 780  
(material) (depth)  
4 if telescope see back.  
(size)

(5) screen 40 780  
(length) (depth to top)  
2 PVC  
(size) (material)

(6) pump 1 25  
(HP) (yield gpm)  
0  
(type power)

(7) electric log No  
(yes or no)  
0  
(organization running log)

CODED

DEPT. OF NATURAL RESOURCES  
BUREAU OF LAND & WATER RESOURCES

APR - 4 1980


RECEIVED

(8) how well bottom plugged  
back wash valve

DRILLERS REMARKS:

If well telescopes please sketch and show depths.

GROUND LEVEL

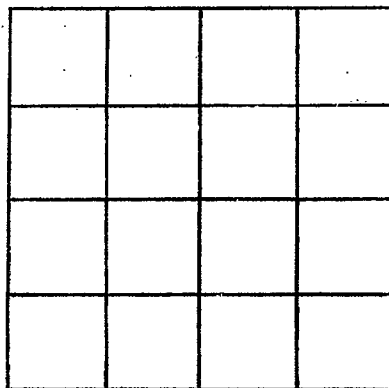

SECTION \_\_\_\_\_

Please indicate well location X.

ADDITIONAL INFORMATION

If more than one screen, show locations of each on sketch.