

MISSISSIPPI DEPARTMENT OF NATURAL RESOURCES

Bureau of Land and Water Resources

Southport Mall

P.O. Box 10631

Jackson, Mississippi 39209

WATER WELL DRILLERS LOG

**CODED**

*Griner Drilling Service, Inc.*

*Warren*

<i>B40</i>
<i>Warren</i>
<i>9-15-83</i>

*9-15-83*  
date well completed

firm name

county well located

LANDOWNER:	description of formations encountered	from	to
<i>Marion Drilling</i>	<i>fill dirt</i>	<i>0</i>	<i>21</i>
<i>P.O. Box 3027</i>			
<i>Daphne, Ala. 3</i>	<i>sand, gravel</i>	<i>21</i>	<i>168</i>
(mailing address)			

**CODED**

WELL LOCATION: *1500'S + 1500'E*  
 sec. *21* T. *18* N. R. *4* E NW/4 of  
 No. *1* *North of Redwood*  
 W. *1/2* miles (distance) (direction) of (nearest town)  
 Thru *1/2*

WELL PURPOSE: *oilfield supply*  
 (home, irrigation, municipal, industrial)

- WELL COMPLETION DATA:
- (1) diameter (inches) *3"*
  - (2) total depth (feet) *168'*
  - (3) static water level (feet) *15'* <sup>*below*</sup> above top of ground.
  - (4) casing *steel* *168'*  
 (material) (depth)  
*3"*  
 (size) if telescope see back.
  - (5) screen *42'* *126'*  
 (length) (depth to top)  
*3"* *perforated*  
 (size) (material)
  - (6) pump *—* *80-95*  
 (HP) (yield gpm)  
*AC*  
 (type power)
  - (7) electric log *—*  
 (yes or no)  
 (organization running log)
  - (8) how well bottom plugged *orange*  
*peel*

DRILLERS REMARKS:


DEPT. OF NATURAL RESOURCES  
 BUREAU OF LAND & WATER RESOURCES

OCT 3 1983

**RECEIVED**

If well telescopes please sketch and show depths.

GROUND LEVEL

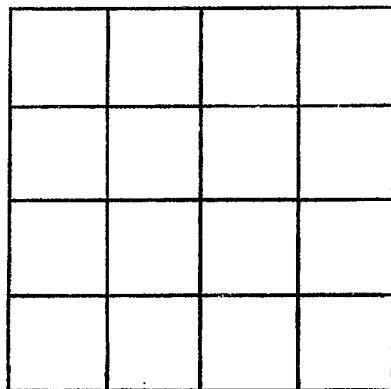

SECTION \_\_\_\_\_

Please indicate well location X.

ADDITIONAL INFORMATION

If more than one screen,  
show locations of each on sketch.