

MISSISSIPPI DEPARTMENT OF NATURAL RESOURCES

Bureau of Land and Water Resources

Southport Mall

P.O. Box 10631

Jackson, Mississippi 39209

WATER WELL DRILLERS LOG

CODED

B41
 WARREN CO.
 3-20-84

March - 20 1984 E. M. Bud Cresswell Warren
 date well completed firm name county well located

LANDOWNER:	description of formations encountered	from	to
Anderson Tully Co. Vicksburg, Ms. (mailing address)			
WELL LOCATION: sec. 18 T. 18 N R. 4 E 2 miles NW of Redwood (distance) (direction) (nearest town)			
WELL PURPOSE: farm (home, irrigation, municipal, industrial)			
WELL COMPLETION DATA:			
(1) diameter (inches) 4			
(2) total depth (feet) 940			
(3) static water level (feet) 5 below top of ground.			
(4) casing steel, 900 (material), (depth) 4 (size) If telescope see back.			
(5) screen 40 900 (length), (depth to top) 2" STAINLESS (size), (material)			
(6) pump 5 50 (HP), (yield gpm) (type power)			
(7) electric log No (yes or no) (organization running log)			
(8) How well bottom plugged back wash valve			
DRILLERS REMARKS:			

CODED


DEPT. OF NATURAL RESOURCES
 BUREAU OF LAND & WATER RESOURCES

APR 16 1984

RECEIVED

If well telescopes please sketch and show depths.

GROUND LEVEL

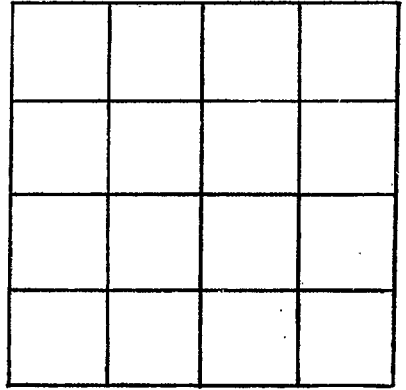

SECTION _____

Please indicate well location X.

ADDITIONAL INFORMATION

If more than one screen, show locations of each on sketch.