

MISSISSIPPI DEPARTMENT OF NATURAL RESOURCES

Bureau of Land and Water Resources

Southport Mall

P.O. Box 10631

Jackson, Mississippi 39209

WATER WELL DRILLERS LOG

COBED

BAZ  
WARREN CO  
3-26-84

March 26 1984 E.M. "Bud" Crosswell WARREN  
date well completed firm name county well located

LANDOWNER:	description of formations encountered	from	to
U.K. Miller Redwood, MS. (mailing address)			
WELL LOCATION: sec. 18 T 18 N R 4 E 2 miles NW of Redwood (distance) (direction) (nearest town)			
WELL PURPOSE: Home (home, irrigation, municipal, industrial)			
WELL COMPLETION DATA:			
(1) diameter (inches) 4			
(2) total depth (feet) 840			
(3) static water level (feet) 8 below top of ground.			
(4) casing PVC 800 (material) (depth) 4 (size) if telescope see back.			
(5) screen 40 800 (length) (depth to top) 2 PVC (size) (material)			
(6) pump 1 20 (HP) (yield gpm) (type power)			
(7) electric log no (yes or no) (organization running log)			
(8) how well bottom plugged back wash valve			
DRILLERS REMARKS:			

COBED


DEPT. OF NATURAL RESOURCES  
BUREAU OF LAND & WATER RESOURCES

APR 16 1984

RECEIVED

If well telescopes please sketch and show depths.

GROUND LEVEL

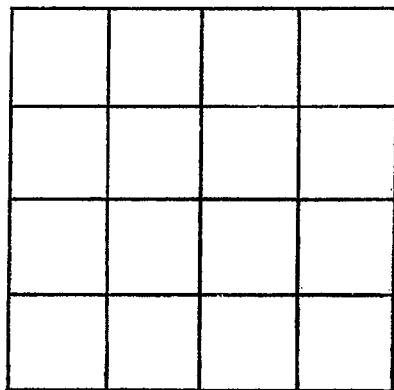

SECTION \_\_\_\_\_

Please indicate well location X.

ADDITIONAL INFORMATION

If more than one screen,  
show locations of each on sketch.