

MISSISSIPPI DEPARTMENT OF ENVIRONMENTAL QUALITY
Bureau of Land and Water Resources

P. O. Box 10631
Jackson, MS 39289-0631
WATER WELL DRILLERS LOG

2260

COUNTY WELL LOCATED
Warren

WELL NUMBER B44 CODED

~~Warren~~

DATE WELL COMPLETED
June 26, 1991

PERMIT NUMBER

NAME OF DRILLING FIRM
EM Bud Cresswell

Benton, Ms

NAME & MAILING ADDRESS OF LANDOWNER
Sneed Flying Service
Redwood, Ms -

WELL LOCATION: SEC 16 TOWNSHIP 18 RANGE 4 ^N _E

DISTANCE 4 Miles DIRECTION North NEAREST TOWN Redwood

OTHER LANDMARK

WELL PURPOSE: Home, Irrigation, Municipal, Industrial, Fish Pond, etc.
FARM

PUMP DATA

PUMP TYPE (Circle One):
Submersible, Turbine, Jet, Flowing Well,
Other (Describe)

POWER TYPE (Circle One):
Electric, Tractor, Diesel, Gasoline, Butane,
Other (Describe) H/P 1

Pump Capacity (GPM) 25 No. of Stages 11 Setting Depth 60 FT.

PUMP TEST

Well yielded 50 GPM with
a drawdown of 10 ft.
after 1/2 hours of pumping

WELL DATA

Well Depth <u>815</u>	Casing Diameter (In.) <u>4x2</u>	Casing Length (Ft.) <u>775</u>
Type of Casing <u>POC</u>	Hole Depth <u>815</u>	Depth to Static Water Level <u>6</u>

TYPE OF COMPLETION: (Circle One or More):
Natural Development, Gravel Packed, Underreamed, Telescoped,
Open Hole, Other

Top of Lap Pipe or Reduction in Casing
140 FEET IF TELESCOPED OR MORE THAN ONE SCREEN: USE BACK PAGE

LOG DATA

TYPE OF LOG RUN (Circle One):
No Log Run, Electric, Gamma Ray, Density, Sonic, Neutron,
Other (Describe) No

Name of Organization Running Log

SCREEN DATA

Diameter - Inches <u>2</u>	Length - Feet <u>40</u>	Slot Size - Inches <u>.010</u>
Screen Type <u>POC</u>	Depth to Bottom - Feet <u>815</u>	

GEOLOGIC DATA (Office Use Only)

Surface Elev.	Geologic Unit	Unit Thickness	Depth to Top
Subs. SW	Date	Analysis	Aquifer Test

Driller's Name

JUL 01 1991


Dept. of Environmental Quality
Bureau of Land & Water Resources

DESCRIPTION OF FORMATIONS ENCOUNTERED	FROM	TO	FORMATIONS (Continued)	FROM	TO
<u>Gumbo</u>	<u>0</u>	<u>20</u>			
<u>Sand-gravel</u>	<u>20</u>	<u>160</u>			
<u>Clay</u>	<u>160</u>	<u>660</u>			
<u>Shale</u>	<u>660</u>	<u>690</u>			
<u>Shale</u>	<u>690</u>	<u>755</u>			
<u>Sand</u>	<u>755</u>	<u>815</u>			

IF MORE SPACE IS NEEDED, USE BACK

If well telescopes please
sketch and show depths.

GROUND LEVEL

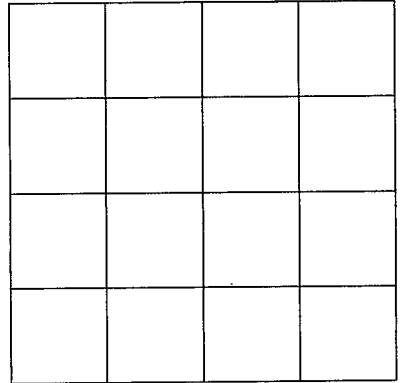

SECTION _____

Please indicate well location X.

ADDITIONAL INFORMATION

If more than one screen,
show location of each on sketch.