

MISSISSIPPI DEPARTMENT OF ENVIRONMENTAL QUALITY
Bureau of Land and Water Resources

P. O. Box 10631
Jackson, MS 39289-0631
WATER WELL DRILLERS LOG

| | |
|--|--|
| COUNTY WELL LOCATED WARREN | |
| WELL NUMBER B 46 | CODED <input checked="" type="checkbox"/> |
| DATE WELL COMPLETED MAY 21, 1993 | |

| |
|--|
| PERMIT NUMBER |
| NAME OF DRILLING FIRM E.M. Bud CRESSWELL |
| BENTONIA, MS - |

| | | | |
|---|--------------|-------------------|--|
| NAME & MAILING ADDRESS OF LANDOWNER INTERNATIONAL Paper Co. Vicksburg, MS - | | | |
| WELL LOCATION: SEC | TOWNSHIP | RANGE | |
| 13 | 18 N | 4 E | |
| DISTANCE | DIRECTION | NEAREST TOWN | |
| 2 Miles | NORTH | of Redwood | |
| OTHER LANDMARK | | | |
| WELL PURPOSE: Home, Irrigation, Municipal, <u>Industrial</u> , Fish Pond, etc. INDUSTRIAL | | | |

| | | |
|---|---------------------------|--------------------------------|
| PUMP DATA | | |
| PUMP TYPE (Circle One): <u>Submersible</u> Turbine, Jet, Flowing Well, Other (Describe) | | |
| POWER TYPE (Circle One): <u>Electric</u> Tractor, Diesel, Gasoline, Butane, Other (Describe) H/P 2 | | |
| Pump Capacity (GPM) 50 | No. of Stages 7 | Setting Depth 63 FT. |
| PUMP TEST | | |
| Well yielded 75 GPM with a drawdown of 10 ft. after 1/2 hours of pumping | | |

| | | |
|---|--|---|
| WELL DATA | | |
| Well Depth 80 | Casing Diameter (In.) 4 | Casing Length (Ft.) 60 |
| Type of Casing PVC | Hole Depth 85 | Depth to Static Water Level 6 |
| TYPE OF COMPLETION: (Circle One or More): Gravel Packed, Underreamed, Telescoped, <u>Natural Development</u> , Open Hole, Other (Describe) | | |
| Top of Lap Pipe or Reduction in Casing | | |
| FEET | IF TELESCOPED OR MORE THAN ONE SCREEN: USE BACK PAGE | |

| | |
|--|--|
| LOG DATA | |
| TYPE OF LOG RUN (Circle One): Electric, Gamma Ray, Density, Sonic, Neutron, Other (Describe) <u>No Log</u> | |
| Name of Organization Running Log | |

| | | |
|---------------------------------|-------------------------------------|-----------------------------------|
| SCREEN DATA | | |
| Diameter - Inches 4 | Length - Feet 20 | Slot Size - Inches .012 |
| Screen Type STAINLESS | Depth to Bottom - Feet 80 | |

| | | | |
|--|---------------|----------------|--------------|
| GEOLOGIC DATA (Office Use Only) | | | |
| Surface Elev. | Geologic Unit | Unit Thickness | Depth to Top |
| Subs. SWL | Date | Analysis | Aquifer Test |

| |
|-------------------|
| Driller's Remarks |
| |
| |


| DESCRIPTION OF FORMATIONS ENCOUNTERED | FROM | TO | FORMATIONS (Continued) | FROM | TO |
|---------------------------------------|-----------|-----------|------------------------|--------------------|----|
| gumbo | 0 | 55 | RECEIVED | JUN 08 1993 | |
| SAND-gravel | 55 | 85 | | | |
| | | | | | |
| | | | | | |
IF MORE SPACE IS NEEDED, USE BACK

Dept. of Environmental Quality
Office of Land & Water Resources

If well telescopes please
sketch and show depths.

GROUND LEVEL

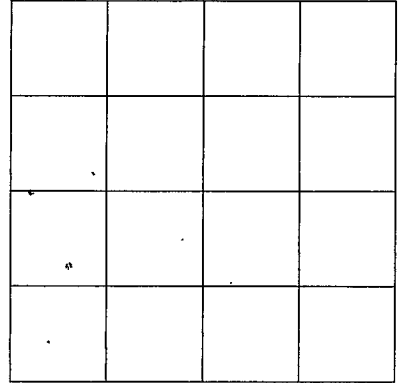

SECTION _____

Please indicate well location X.

ADDITIONAL INFORMATION

If more than one screen,
show location of each on sketch.