30 days of completion of drilling		Well #: <u>B-65</u> L. S. Elevation: E-log #: with the Department within	
Well Owner Inform		Well Location	
Owner NameSimrall & Si	mrall Latitude: 32 . 32 . 5	57N Longitude: 90, 46, 10W	
Mailing Address: 5040 Hwy.3	Method of Lat/Long (circle	one): Conventional Survey,	
Redwood, MS City St Telephone No. ()	39156 SE ¼ SW ¼ Sec 12 ate Zip Code Distance Direction		
······································	Well Data		
Purpose of Well (circle one) Home Ind	dustrial Public Supply Irrigation Fish Culture	Other:	
	-04 Date well drilling completed:		
	alve Other (describe)		
	<u> </u>		
Static Water Level: <u>17ft</u> feet a Method of Measurement (circle one) Hole depth: <u>116'</u> Well do	bove or below (circle one) land surface Date measure steel tape electric tape air line other: epth:115' Well grouted to a depth o	d: 10-5-04	
Static Water Level: <u>17ft</u> feet a Method of Measurement (circle one) Hole depth: <u>116</u> Well de Type of grout (circle one): Cement	bove or below (circle one) land surface Date measure steel tape electric tape air line other: epth:116' Well grouted to a depth o Bentonite Mix	d: <u>10-5-04</u> f <u>10</u> feet	
Static Water Level: <u>17ft</u> feet a Method of Measurement (circle one) Hole depth: <u>116'</u> Well de Type of grout (circle one): Cement Casing length: <u>76</u> feet Casi	bove or below (circle one) land surface Date measure steel tape electric tape air line other: epth:16' Well grouted to a depth o Bentonite Mix ing diameter:16 inches Type of casing	d: 10-5-04 f 10 feet PVC Sch.40	
Static Water Level: <u>17ft</u> feet a Method of Measurement (circle one) Hole depth: <u>116'</u> Well de Type of grout (circle one): Cement Casing length: <u>76</u> feet Casi Screen length: <u>40</u> feet Scr	bove or below (circle one) land surface Date measure steel tape electric tape air line other: epth:116' Well grouted to a depth or Bentonite Mix ing diameter:16inches Type of casing reen diameter:16inches Type of screen:	d: 10-5-04 f 10 feet PVC Sch.40 PVC Sch.40	
Static Water Level: <u>17ft.</u> feet a Method of Measurement (circle one) Hole depth: <u>116'</u> Well de Type of grout (circle one): Cement Casing length: <u>76</u> feet Casi Screen length: <u>40</u> feet Scr Screen slot size: <u>050</u> inches	bove or below (circle one) land surface Date measure steel tape electric tape air line other: epth:115' Well grouted to a depth o Bentonite Mix ing diameter:16inches Type of casing reen diameter:16inches Type of screen: Setting depth: From77feet to	d: 10-5-04 f 10 feet PVC Sch.40 <u>PVC Sch.40</u> 116 feet	
Static Water Level: <u>17ft.</u> feet a Method of Measurement (circle one) Hole depth: <u>116'</u> Well de Type of grout (circle one): Cement Casing length: <u>76</u> feet Casi Screen length: <u>40</u> feet Scr Screen slot size: <u>050</u> inches	bove or below (circle one) land surface Date measure steel tape electric tape air line other: epth:116' Well grouted to a depth or Bentonite Mix ing diameter:16inches Type of casing reen diameter:16inches Type of screen:	d: 10-5-04 f 10 feet PVC Sch.40 <u>PVC Sch.40</u> 116 feet	
Static Water Level: <u>17ft.</u> feet a Method of Measurement (circle one) Hole depth: <u>116'</u> Well de Type of grout (circle one): Cement Casing length: <u>76</u> feet Casi Screen length: <u>40</u> feet Scr Screen slot size: <u>050</u> inches	bove or below (circle one) land surface Date measure steel tape electric tape air line other: epth:115' Well grouted to a depth o Bentonite Mix ing diameter:16inches Type of casing reen diameter:16inches Type of screen: Setting depth: From77feet to	d: <u>10-5-04</u> f <u>10</u> feet <u>PVC Sch. 40</u> <u>PVC Sch. 40</u> <u>116</u> feet en hole Natural Development	
Static Water Level: <u>17ft.</u> feet a Method of Measurement (circle one) Hole depth: <u>116'</u> Well de Type of grout (circle one): Cement Casing length: <u>76</u> feet Casi Screen length: <u>40</u> feet Scr Screen slot size: <u>050</u> inches Type of completion (circle all applicable).	bove or below (circle one) land surface Date measure steel tape electric tape air line other: epth:115' Well grouted to a depth of Bentonite Mix ing diameter:16inches Type of casing een diameter:16inches Type of screen: Setting depth: From77feet to : Gravel packed Underreamed Telescoped Op	d: <u>10-5-04</u> f <u>10</u> feet <u>PVC Sch.40</u> <u>PVC Sch.40</u> <u>116</u> feet en hole Natural Development	
Static Water Level: <u>17ft.</u> feet a Method of Measurement (circle one) Hole depth: <u>116'</u> Well de Type of grout (circle one): Cement Casing length: <u>76</u> feet Casi Screen length: <u>40</u> feet Scr Screen slot size: <u>050</u> inches Type of completion (circle all applicable).	bove or below (circle one) land surface Date measure steel tape electric tape air line other: epth:116' Well grouted to a depth of Bentonite Mix ing diameter:6 inches Type of casing reen diameter:6 inches Type of screen: Setting depth: From77 feet to : Gravel packed Underreamed Telescoped Op Other (describe):	d: 10-5-04 f 10 feet PVC Sch. 40 PVC Sch. 40 116 feet en hole Natural Development screen, describe on back of page	
Static Water Level: <u>17ft.</u> feet a Method of Measurement (circle one) Hole depth: <u>116'</u> Well de Type of grout (circle one): Cement Casing length: <u>76</u> feet Casi Screen length: <u>40</u> feet Scr Screen slot size: <u>050</u> inches Type of completion (circle all applicable): Top of lap pipe or reduction in casing: <u>Logs run (circle all applicable)</u> to log ru Name of organization running log(s): <u></u>	bove or below (circle one) land surface Date measure steel tape electric tape air line other: epth:116' Well grouted to a depth of Bentonite Mix ing diameter:16inches Type of casing een diameter:16inches Type of screen: Setting depth: From77feet to : Gravel packed Underreamed Telescoped Op Other (describe): feet. If telescoped or more than one so un Electric Gamma Ray Density Sonic Neutron	d: <u>10-5-04</u> f <u>10</u> feet <u>PVC Sch. 40</u> <u>PVC Sch. 40</u> <u>116</u> feet en hole Natural Development Screen, describe on back of page Other:	
Static Water Level: 17ft. feet a Method of Measurement (circle one) Image: Circle one) Hole depth: 116' Well de Type of grout (circle one): Cement Casing length: 76 feet Casing Screen length: 40 feet Screen Screen slot size: 050 inches Type of completion (circle all applicable) Top of lap pipe or reduction in casing:	bove or below (circle one) land surface Date measure steel tape electric tape air line other:	d: 10-5-04 f 10 feet PVC Sch. 40 PVC Sch. 40 116 feet en hole Natural Development screen, describe on back of page Other: le requirements of the Mississippi	
Static Water Level: 17ft. feet a Method of Measurement (circle one) Image: Circle one) Hole depth: 116' Well de Type of grout (circle one): Cement Casing length: 76 feet Casing Screen length: 40 feet Screen Screen slot size: 050 inches Type of completion (circle all applicable) Top of lap pipe or reduction in casing:	bove or below (circle one) land surface Date measure steel tape electric tape air line other: epth:116' Well grouted to a depth of Bentonite Mix ing diameter:16inches Type of casing een diameter:16inches Type of screen: Setting depth: From77feet to : Gravel packed Underreamed Telescoped Op Other (describe): feet. If telescoped or more than one s un Electric Gamma Ray Density Sonic Neutron ructed, and completed in accordance with all application and/or the Mississippi Department of Health regulation ment Inc.	d: 10-5-04 f 10 feet PVC Sch. 40 PVC Sch. 40 116 feet en hole Natural Development screen, describe on back of page Other: le requirements of the Mississippi	


OCT 11 2004 BY: OLWR If well telescopes please sketch below and show depths.

B-65

Ground Level

Des	cription of Formations Encountered	From	То
Clay		10	35
Fine	Sand	36	41
Fine	Sand/gravel	42	48
Med.	Sand/gravel Sand/gravel	49	116
			<u> </u>
<u> </u>			
	·		
	•		
			
			ļ

If more than one screen, show location of each on sketch

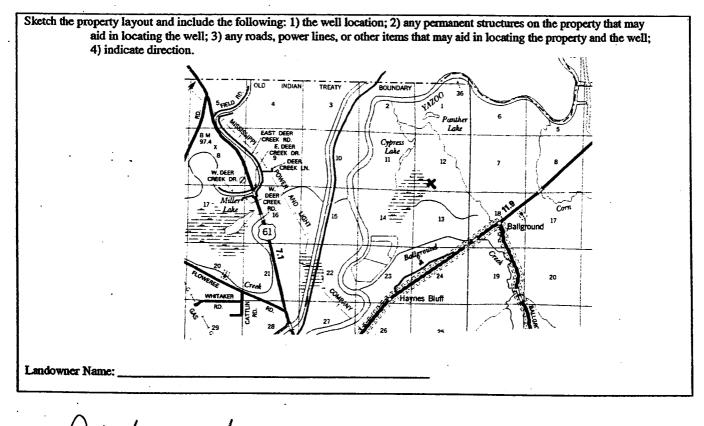

Signature of Water Well Contractor

Irrigati Driller: Date completed: _	on Equipment 10-5-04	Jackson, MS 39289-0631 (601)961-5210 (601)354-6938 (fax)		For Office Use Only: Aquifer: Well #: <u>B - 65</u> Elevation:	
This report installation	should be prepared by a of pump. Well Owner Informa		tail and filed with the Departme		ays of the
Oumer Neme				ll Location	
Owner Name: Simrall & Simrall Mailing Address: 5040 Hwy.3		Latitude:Longitude: Method of Lat/Long (circle one): Conventional Survey,			
Telephone No. (Redwood, MS City State	Zip Code	USGS quad, Hand $SE \frac{1}{4} SW \frac{1}{4} Sec_{12}$ Distance Direction $\frac{6}{Miles} North$	2Twn18 Nearest T	^{SN} Rng <u>4</u> E
Pump Type Circle one		Power Type Circle one			
Air Lift	Jet	Submersible		te Engine	Natural Gas
Bucket	Piston	Turbine	Electric Motor Hand	5	Tractor PTO
Centrifugal	Rotary	Flowing Well	Windmill Other	(specify):	
Other (specify): _			Horse Power Rating of Motor	125	
Date Pump Install	ed: <u>10-5-04</u>		Setting Depth:		feet
Rated Pump Capac		_Gallons Per Minute	Number of Stages:4		
Pump Test Data		Method of Measuring Water Level Circle one			
Static Water Level	(A): <u>17</u> Feet	Below Land Surface	Air Line Electric Mean Other (specify):	•	Steel Tape
Drawdown [(B) - ((A)]:Feet	Below Land Surface	For flowing well, measured sh	ut in head:	feet
Test Pumping Rate	: <u></u>	Gallons Per Minute	Well yielded		
		hours	feet after		

Print Name of Pump Installer and License No. (if applicable)

Signature of Pump Installer

RECEIVED OCT 1 1 2004 BY: OLWR