

Dorn Bush #1

State Well Report Part 1

Mississippi Department of Environmental Quality
Office of Land and Water Resources
P.O. Box 10631
Jackson, MS 39289-0631
(601)961-5210
(601)354-6938 (fax)

For Office Use Only:

Aquifer: _____
Well #: R-7.5
L. S. Elevation: _____
E-log #: _____

HARREN

42406

J. NEWCOME 0-773

drilling completed: 3-17-08

State Law requires that this report be prepared by the driller in detail and filed with the Department within 30 days of completion of drilling of the well.

Well Owner Information	Well Location
Owner Name: <u>FLAUREE PLANTING CO</u>	Latitude: <u>32.32.53"</u> Longitude: <u>090.50.19"</u>
Mailing Address: <u>3360 FLAUREE RD.</u>	Method of Lat/Long (circle one): Conventional Survey
<u>REDWOOD, MS. 39156</u>	USGS quad. (<u>Hand-held GPS</u>) Survey-grade GPS
City State Zip Code	<u>NE</u> 1/4 <u>SE</u> 1/4 Sec. <u>18</u> Twn <u>8N</u> Rng <u>4E</u>
Telephone No: <u>601-638-0934</u>	Distance Direction Nearest Town
	<u>10</u> Miles <u>N</u> of <u>VICKSBURG</u>

Well Data

Purpose of Well (circle one) Home Industrial Public Supply Irrigation Fish Culture Other: _____

Date well drilling started: 3-17-08 Date well drilling completed: 3-17-08

If flowing, method of flow regulation: Valve _____ Other (describe) _____

Static Water Level: _____ feet above or below (circle one) land surface Date measured: _____

Method of Measurement (circle one) steel tape electric tape air line other: _____

Hole depth: 123 Well depth: 120 Well grouted to a depth of 10 feet

Type of grout (circle one): Cement Bentonite Mix

Casing length: 80 feet Casing diameter: 16 inches Type of casing: PVC

Screen length: 40 feet Screen diameter: 16 inches Type of screen: PVC

Screen slot size: 0.50 inches Setting depth: From 60-80 feet to 100-120 feet

Type of completion (circle all applicable): Gravel packed Underreamed Telescoped Open hole Natural Development

Other (describe): _____

Top of lap pipe or reduction in casing: _____ feet. If telescoped or more than one screen, describe on back of page

Logs run (circle all applicable): No log run Electric Gamma Ray Density Sonic Neutron Other: _____

RECEIVED

APR 14 2008

Name of organization running log(s): _____
I certify that the well was drilled, constructed, and completed in accordance with all applicable requirements of the Mississippi Department of Environmental Quality and/or the Mississippi Department of Health regulations and state laws.

JOHN NEWCOME 0-773
Print Name of Water Well Contractor and License No.

John Newcome
Signature of Water Well Contractor

42406

State Well Report

Part 1

Mississippi Department of Environmental Quality
Office of Land and Water Resources
P.O. Box 10631
Jackson, MS 39289-0631
(601)961-5210
(601)354-6938 (fax)

For Office Use Only:

Aquifer: _____
Well #: B-75
L. S. Elevation: _____
E-log #: _____

County: WARREN
Permit #: 6W42406
Driller: J. NEWCOME 0-773
Date drilling completed: 3-17-08

State Law requires that this report be prepared by the driller in detail and filed with the Department within 30 days of completion of drilling of the well.

Well Owner Information	Well Location
Owner Name: <u>FLAUREE PLANTING CO</u>	Latitude: <u>32° 32' 53"</u> Longitude: <u>090° 50' 19"</u>
Mailing Address: <u>3360 FLAUREE RD.</u>	Method of Lat/Long (circle one): Conventional Survey, <u>Hand-held GPS</u> , Survey-grade GPS
<u>REDWOOD, MS. 39156</u>	USGS quad, <u>NE</u> 1/4 <u>SE</u> 1/4 Sec <u>18</u> Twn <u>8N</u> Rng <u>4E</u>
City State Zip Code	Distance <u>10</u> Miles Direction <u>N</u> of Nearest Town <u>VICKSBURG</u>
Telephone No: <u>601-638-0934</u>	

Well Data

Purpose of Well (circle one) Home Industrial Public Supply Irrigation Fish Culture Other: _____

Date well drilling started: 3-17-08 Date well drilling completed: 3-17-08

If flowing, method of flow regulation: Valve _____ Other (describe) _____

Static Water Level: _____ feet above or below (circle one) land surface Date measured: _____

Method of Measurement (circle one) steel tape electric tape air line other: _____

Hole depth: 123 Well depth: 120 Well grouted to a depth of 10 feet

Type of grout (circle one): Cement Bentonite Mix

Casing length: 80 feet Casing diameter: 16 inches Type of casing: PVC

Screen length: 40 feet Screen diameter: 16 inches Type of screen: PVC

Screen slot size: 0.50 inches Setting depth: From 60-80 feet to 100-120 feet

Type of completion (circle all applicable): Gravel packed Underreamed Telescoped Open hole Natural Development

Other (describe): _____

Top of lap pipe or reduction in casing: _____ feet. If telescoped or more than one screen, describe on back of page

Logs run (circle all applicable): No log run Electric Gamma Ray Density Sonic Neutron Other: _____

Name of organization running log(s): _____

I certify that the well was drilled, constructed, and completed in accordance with all applicable requirements of the Mississippi Department of Environmental Quality and/or the Mississippi Department of Health regulations and state laws.

JOHN NEWCOME 0-773

Print Name of Water Well Contractor and License No.

Signature of Water Well Contractor

RECEIVED


APR 10 2008

BY: OLWR

If well telescopes please sketch below and show depths.

B-75


Ground Level

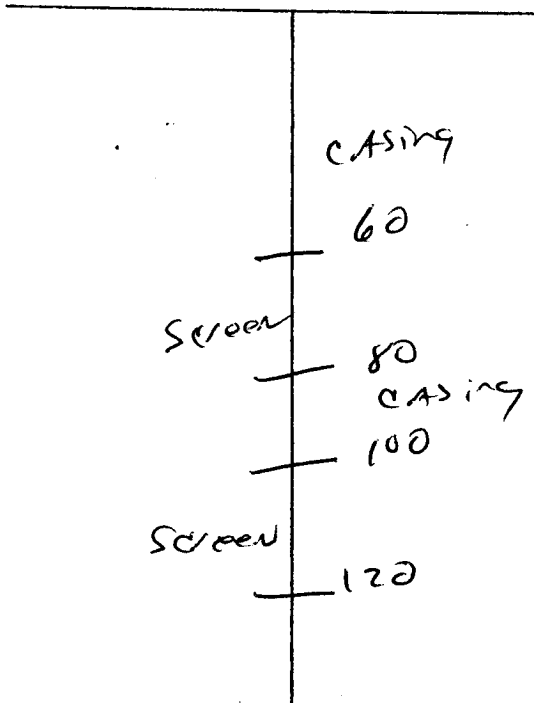


Description of Formations Encountered	From	To
TOP SOIL	0	10
Mix CLAY	10	40
Fine Sand	40	60
Med COARSE Sand	60	80
Fine Sand	80	100
COARSE Sand	100	120
Sand CLAY mix	120	123

If more than one screen, show location of each on sketch

Sketch the property layout and include the following: 1) the well location; 2) any permanent structures on the property that may aid in locating the well; 3) any roads, power lines, or other items that may aid in locating the property and the well; 4) indicate direction.

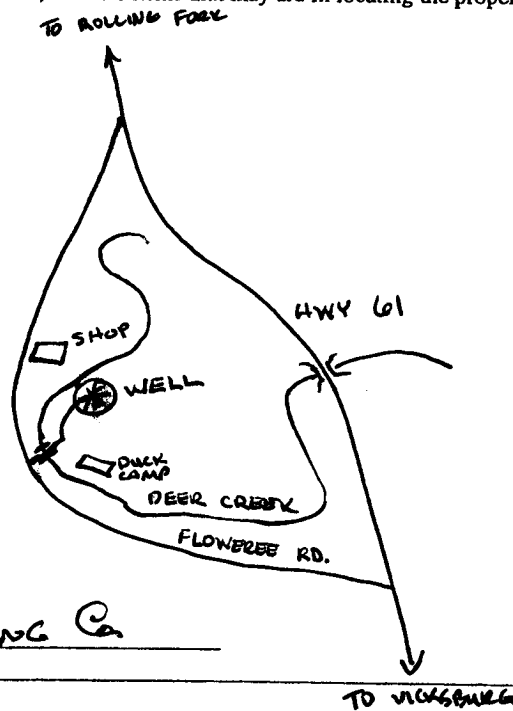

Landowner Name: FLOWERS PLANTING Co.

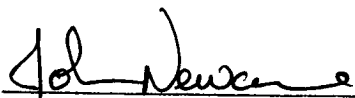
 Signature of Water Well Contractor

STATE WELL REPORT

Part 2

Pump Installer's Completion Report
 Mississippi Department of Environmental Quality
 Office of Land and Water Resources
 P.O. Box 10631
 Jackson, MS 39289-0631
 (601)961-5210
 (601)354-6938 (fax)

County: WARREN
 Permit #: OW42406
 Driller: J. NEWCOMB 0-773
 Date completed: 3-17-08

For Office Use Only:

Aquifer: _____
 Well #: B-75
 Elevation: _____

This report should be prepared by the pump installer in detail and filed with the Department within 30 days of the installation of pump.

Well Owner Information

Owner Name: FLOWREE PLANTING CO.
 Mailing Address: 3360 FLOWREE RD.
REDWOOD, MS. 39156
 City State Zip Code
 Telephone No: 601-638-0934

Well Location

Latitude: 32-32-53 Longitude: 090-50-19
 Method of Lat/Long (circle one): Conventional Survey,
 USGS quad, Hand-held GPS, Survey-grade GPS
NE 1/4 SE 1/4 Sec 18 Twn 8N Rng 4E
 Distance Direction Nearest Town
10 Miles N of VIKSBURG

Pump Type
Circle one

Air Lift Jet Submersible
 Bucket Piston Turbine
 Centrifugal Rotary Flowing Well
 Other (specify): _____
 Date Pump Installed: 3-21-08
 Rated Pump Capacity: 3000 Gallons Per Minute

Power Type
Circle one

Diesel Engine Gasoline Engine Natural Gas
 Electric Motor Hand Tractor PTO
 Windmill Other (specify): _____
 Horse Power Rating of Motor: _____
 Setting Depth: 60 feet
 Number of Stages: 1-STAGE / 4LWS

Pump Test Data

Date Well Tested: _____
 Static Water Level (A): _____ Feet Below Land Surface
 Pumping Water Level (B): NO TEST Feet Below Land Surface
 Drawdown [(B) - (A)]: _____ Feet Below Land Surface
 Test Pumping Rate: _____ Gallons Per Minute
 Duration of Pump Test (minimum 4 hours): _____ hours

Method of Measuring Water Level
Circle one

Air Line Electric Measuring Line Steel Tape
 Other (specify): _____
 For flowing well, measured shut in head: _____ feet
 Well yielded _____ GPM with a drawdown of _____ feet after _____ hours of pumping

I HEREBY CERTIFY that the above statements are true to the best of my knowledge.

CHEN Rowe - #7108 _____
 Print Name of Pump Installer and License No. (if applicable) Signature of Pump Installer

RECEIVED
 APR 10 2008
 BY: OLWR