
	DORNBUSCH	# 4	
*			
County: Warren Permit #: <u>GW- 45548</u> Driller: <b>J.NEWCOME 0:773</b> Date drilling completed: <u>3.7.2012</u>	State Well Report Part 1 – Driller's Log Mississippi Department of Environmental Quality Office of Land and Water Resources P.O. Box 2309 Jackson, MS 39225 (601)961- 5210 (601)961- 5228 (fax)		For Office Use Only:           Aquifer:           Well #:         B & A           L. S. Elevation:
State Law requires that this repor	t he prepared by the lie	ansa haldar rasnansihla far	E-log #:
Department at the above address			
Information on Well O ( <i>Landowner if borehole is not fo</i> Owner Name <u>Floweree Play</u> Mailing Address: <u>3360 Flowe</u>	nt ing Conpany	Latitude: <u>32 • 32 • 34</u> Method of Lat/Long (circle or USGS guad, <b>H</b> and-held	GPS, Survey-grade GPS
Reduced Mc City Stat	1 4 4 <sup>2</sup> 1 4 3 1	$\frac{1}{5}$ Distance Direction $6.5$ Miles $5.$	Twn 18N Rng OME Nearest Town of VALLEY PARK
	Well / Bore	hole Data	
Date drilling started: 3.7.2012 Date dri Location of the source of any surface wate Method of dosing and volume of Chlorine Logs run (circle all applicable). No log run Name of organization running log(s):	er used for drilling: CRE e used in drilling and devel	opment: CHLORINE T	ABLETS
Purpose of borehole (check one): Water W	ell Geotechnical/Geol	ogical Investigation Ground	l Source Heat Pump
Seismic S If drilling is not related	Survey Other (describe to water well constructio	) n, skip the remainder of this bl	ock
Purpose of Well (check one): Home In			
If a flowing well, method of flow regulatio			
Static Water Level:feet ab			
Method of Measurement (circle one) st			
Well depth: <u>20</u> Well grouted to a de Casing length: <u>60</u> feet Casir Screen length: <u>40</u> feet Scre	ng diameter: 1D		P.V.C.
Screen slot size: .050 inches	Setting depth: From _	80 _feet to 12	feet
Type of completion (circle all applicable);	Gravel packed Under	rreamed Telescoped Open	hole Natural Development
	Other (describe):		
Top of lap pipe or reduction in casing:	feet. If te	lescoped or more than one scre	een, describe on next page
			Form: OLWR-SWR-1A (04/

RECEIVED MAY 2 3 2012 BY: OLWR The sketch below only required for water wells

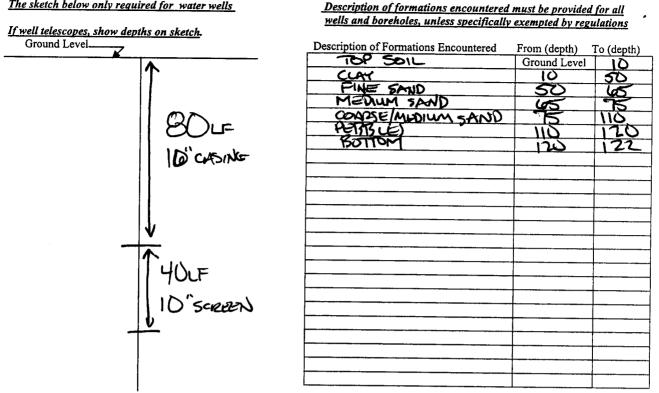

If more than one screen, show location of each on sketch

<ul><li>Sketch the property layout and include the following: 1) the well location aid in locating the well; 3) any roads, power lines, or other 4) a north arrow.</li></ul>	h; 2) any permanent structures on the property that may items that may aid in locating the property and the well;
4	
SEE MAP.	
Landowner Name:	
	Form: OLWR-SWR-1A (04/

I certify that the well/borehole was drilled, constructed, and completed in accordance with all applicable requirements of the Mississippi Department of Environmental Quality and the Mississippi Department of Health regulations, if applicable, and state laws.

JOHN NEWCOME 0.773 3.7.2012

Print Name of Responsible Licensee and License No.

Date

Signature of Licensee

	STATE WE	ELL REPORT		
County: Warren	Part 2		For Office Use Only:	
Permit #: GW - 45548	Pump Installer's Completion Report		Aquifer:	
	Mississippi Department of Environmental Quality Office of Land and Water Resources			
Driller: J. Newcome D-773	P.O.	Box 2309	Well #: 682	
Date completed: <u>3-7-2012</u>		n, MS 39225 961-5210	Elevation:	
Copy information from block on Part 1	· · ·	1-5228 (fax)		
This part of the report must be completed b report must be attached and both parts file.				
Well Owner Information			ll Location	
Owner Name: Floweree Planting Company		Latitude: <u>32 32 34</u> Longitude: <u>90 51 18</u>		
Mailing Address: 3360 Floweree Road		Method of Lat/Long (check one): Conventional Survey,		
		USGS quad , Hand-held	GPS, Survey-grade GPS	
Redwood MS 39156 City State Zip Code		SKO 1/4 NW 1/4 Sec 18 T 18 N R 04 E		
Telephone No. ()	8 · · · · · · · · · · · · · · · · · · ·	0.5 Miles $5.0$	of Valley Park	
Pump Type		Po	wer Type	
Air Lift Jet	Submersible	-	Circle one ne Engine Natural Gas	
Bucket Piston	Turbine 🤇	Electric Motor Hand	Tractor PTO	
Centrifugal Rotary	Flowing Well	Windmill Other	(specify):	
Other (specify):		Horse Power Rating of Motor	. 15	
Date Pump Installed: 449112	L	Setting Depth: 70	feet	
Rated Pump Capacity: <u>400</u>	Gallons Per Minute	Number of Stages:		
Pump Test Data		Method of Me	easuring Water Level	
Date Well Tested:	<u></u> _		Circle one asuring Line Steel Tape	
Static Water Level (A):Feet I	Below Land Surface			
		Other (specify):		
Pumping Water Level (B):Feet B	elow Land Surface	and the second	and the second	
Drawdown [(B) – (A)]: Feet H		For flowing well, measured st	hut in head:feet	
Test Pumping Rate:Gallons Per Minute		Well yielded	GPM with a drawdown of	
Duration of Pump Test (minimum 4 hours):	hours	feet after	hours of pumping	
This is for (circle one): New Well	Replacement of Exi	sting Pump Repair of E	xisting Pump	
I HEREBY CERTIFY that the above statem	ents are true to the best o	f my knowledge		
Print Name of Pump Installer and License N	0-711P	Signature of ump Ii	DUL RECEIVE	
			Form: OLWR-SWR1 (07-99)71	
			MAY (2-39	

٠

٦

•

5 7 6.1

	OLWR
--	------