

Warren
B 3550
10-67

MISSISSIPPI
BOARD OF WATER COMMISSIONERS
416 North State Street
Jackson, Mississippi 39201

WATER WELL DRILLERS LOG

Oct 19 1967 J H Barnes WARREN
date well completed firm name county well located

LANDOWNER: ILLINOIS
CENTRAL R.R. Co.
CHICAGO ILL.
(mailing address)


description of formations encountered	from	to
top Soil	35	35
Sand	15	50
Light Blue Shell	80	165
Shell Blue	300	465
Beaver Shell	700	665
Rock with sand		
thin layers	35	690
Sand & Light		
light	101	179
sand	600	851
Shell Dark	80	741
sand	50	991
Rock		1992
sand	128	1120

WELL LOCATION:
sec. 18 T 18 N R 4 E S 1 W
5 miles NORTH of REDWOOD
(distance) (direction) (nearest town)

WELL PURPOSE: INDUSTRIAL
(home, irrigation, municipal, industrial)

- WELL COMPLETION DATA:
- (1) diameter (inches) 6"
 - (2) total depth (feet) 1120
 - (3) static water level (feet) 10 below above top of ground.
 - (4) casing Pipe 1120 (material) (depth)
6" (size) If telescope see back.
 - (5) screen 30 1090 (length) (depth to top)
4" (size) Stainless Steel (material)
 - (6) pump 3 60 (HP) (yield gpm)
Elect. (type power)
 - (7) electric log No (yes or no)
(organization running log)
 - (8) how well bottom plugged Back Wash Valve

DRILLERS REMARKS:

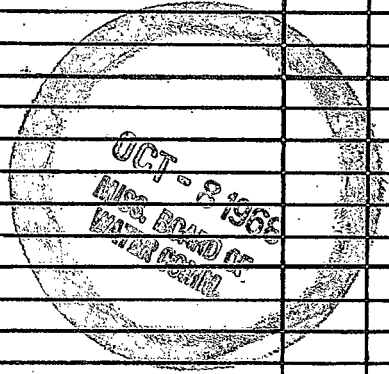



If well telescopes please sketch and show depths.

GROUND LEVEL

6''

200 feet

4''


890 feet

30 feet

4'' Screen

no. 10

slat

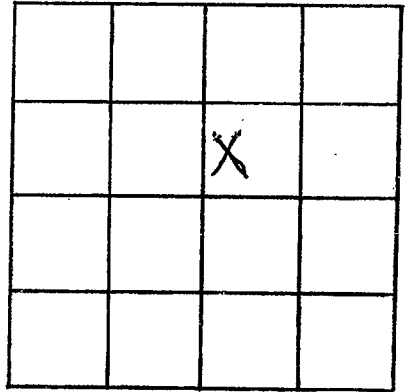

SECTION 18

Please indicate well location X.

ADDITIONAL INFORMATION

If more than one screen,
show locations of each on sketch.