

WARREN
 B 2001
 3-14-77

MISSISSIPPI
 BOARD OF WATER COMMISSIONERS
 416 North State Street
 155 Jackson, Mississippi 39201

WATER WELL DRILLERS LOG

MARCH 14 1977 E.M. "Bud" CRESSWELL WARREN
 date well completed firm name county well located

LANDOWNER:
 Dorothy G. Butts
 Redwood, Ms.
 (mailing address)

description of formations encountered	from	to
clay	0	45
an apt gravel	45	100

WELL LOCATION:
 sec. 21 T18 N R 4 E
 4 miles N of Redwood
 (distance) (direction) (nearest town)

WELL PURPOSE: none
 (home, irrigation, municipal, industrial)


- WELL COMPLETION DATA:
- (1) diameter (inches) 2
 - (2) total depth (feet) 100
 - (3) static water level (feet) 18 below top of ground
 - (4) casing PVC 95 (material) (depth)
 2 (size) if telescope see back.
 - (5) screen 5 95 (length) (depth to top)
 2" (size) PVC (material)
 - (6) pump 0 0 (HP) (yield gpm)
 0 (type power)
 - (7) electric log no (yes or no)
 0 (organization running log)
 - (8) how well bottom plugged Steel Plug

DRILLERS REMARKS:

RECEIVED
 APR 12 1977
 MISS. Bd. OF WATER COMMISSIONERS

If well telescopes please sketch and show depths.

GROUND LEVEL

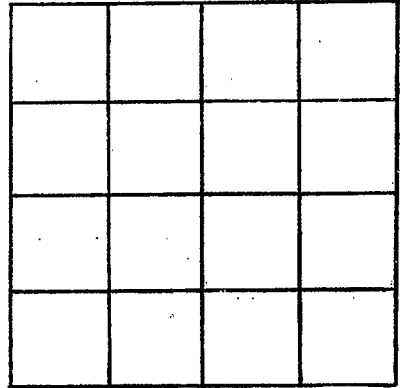

SECTION _____

Please indicate well location X.

ADDITIONAL INFORMATION

If more than one screen,
show locations of each on sketch.